

Application No. R-73512
Permit No.


"CERTIFICATE NO. 68915"

RECEIVED

AUG - 1979

WATER RESOURCES DEPT
SALEM, OREGON

T. 22 S. R. 42 E. W.M.

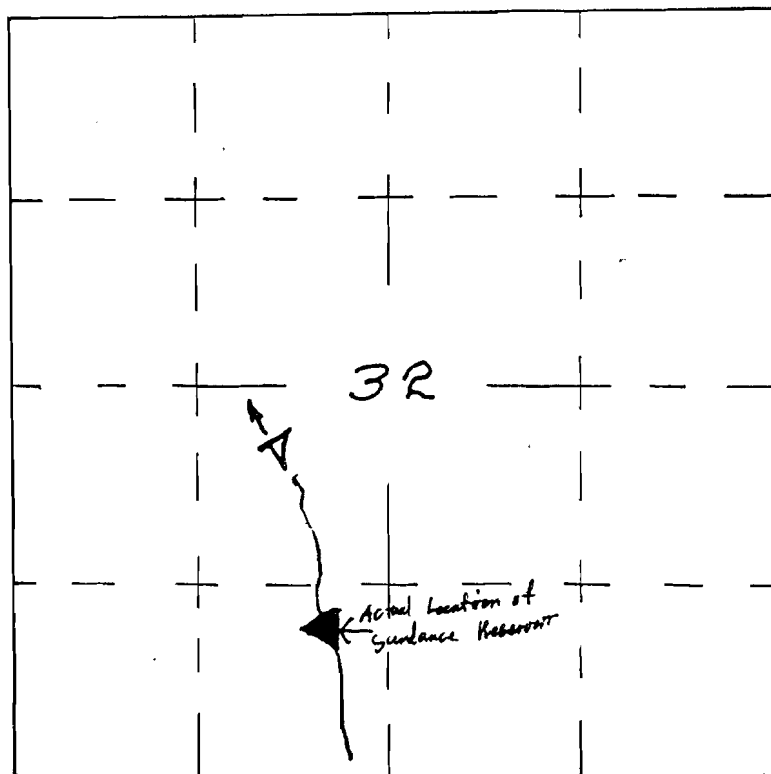

Application No. R59048
Permit No. R 8695

U. S. DEPARTMENT OF THE INTERIOR
BUREAU OF LAND MANAGEMENT

SUNDANCE

DESIGNED _____

RECOMM. _____

DRAWN _____

RECOMM. _____

CHIEF, DIV. OF ENG.

CHECKED _____

APPROVED _____

SCALE _____

DATE _____

SHEET _____ OF _____

DRAWING NO. _____