

Form AI-187
March 1961


UNITED STATES
DEPARTMENT OF THE INTERIOR
BUREAU OF LAND MANAGEMENT

Permit No. 68919
"CERTIFICATE NO. 68919

SECTION 8 SESE

Oregon State Water Filings

TOWNSHIP 26 S, RANGE 37 E, W. M.

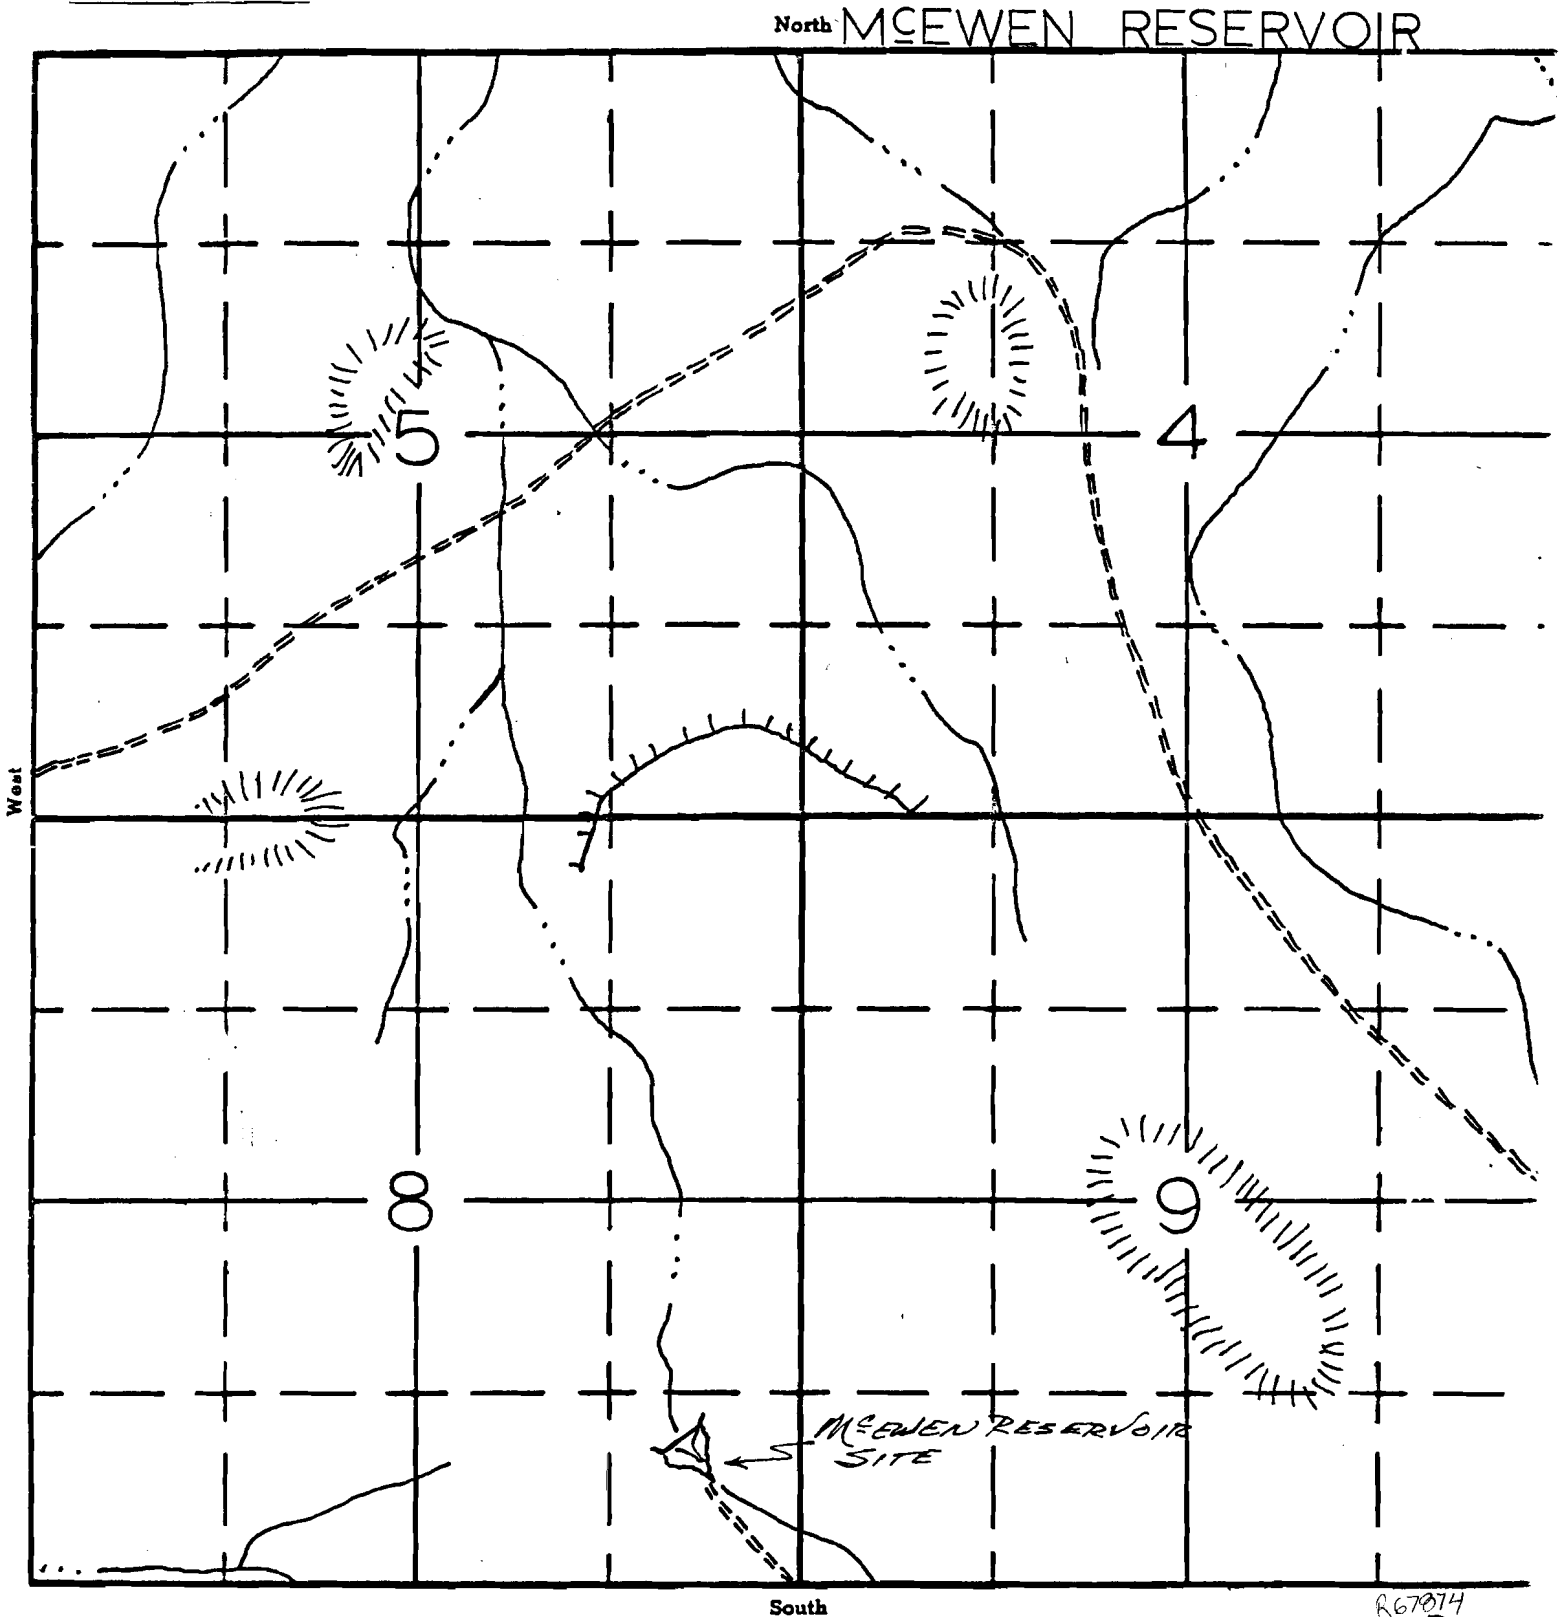

APPLICATION No. R-67
PERMIT No. R106