

Form AI-187
March 1961

UNITED STATES
DEPARTMENT OF THE INTERIOR
BUREAU OF LAND MANAGEMENT

RECEIVED
SEP 30 1983
WATER RESOURCES
SALEM, OREGON

Permit No.
SECTION 4

Oregon State Water Filings


SWSW

TOWNSHIP 18 S, RANGE 38 E, W. M.

CERTIFICATE NO. 68921

WILLOW BASIN

Application No. R-67074
Permit No. R10308

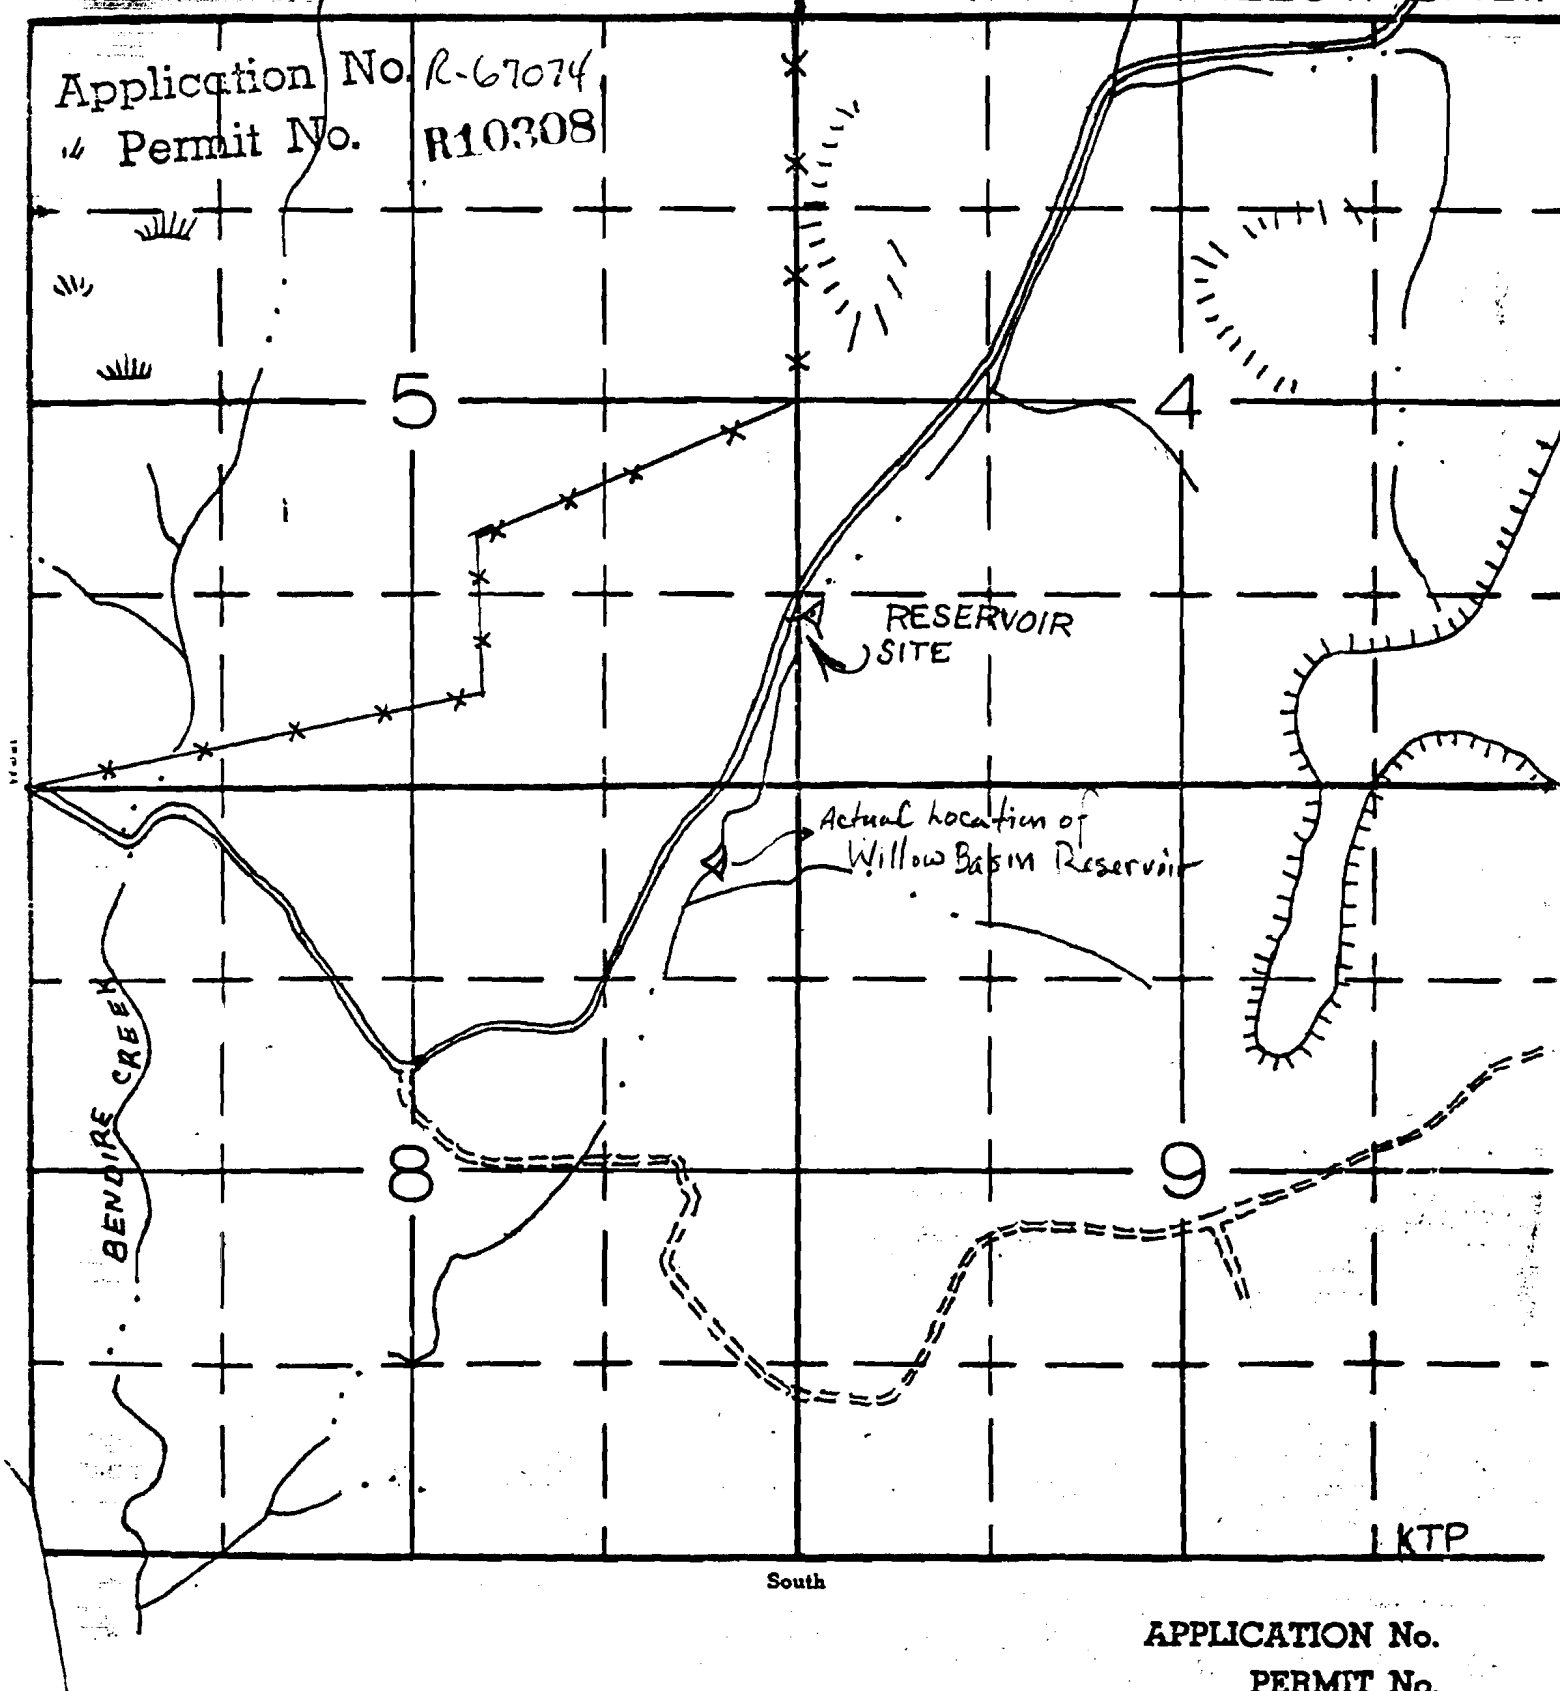

APPLICATION No.
PERMIT No.