

Application No. R-775 25


Permit No.

"CERTIFICATE NO. 68928"

SECTION 13

SW $\frac{1}{4}$ NW $\frac{1}{4}$

TOWNSHIP 31S RANGE 38E W.M.

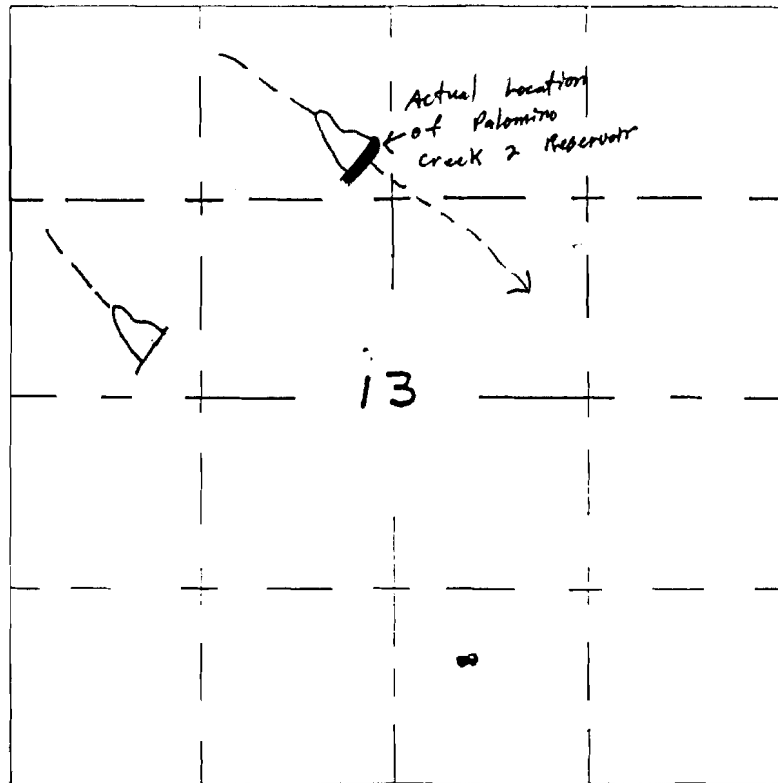

Palamino crk. #2

No R59037

Permit No. R 8687

RECEIVED

APR 6 1983

WATER RESOURCES DEPT.
SALEM, OREGON