

Application No. R-73526
Permit No.


"CERTIFICATE NO. 68929"

RECEIVED

APR 17 1979

WATER RESOURCES DIVISION

T. 24 S. R. 37 E. W.M.

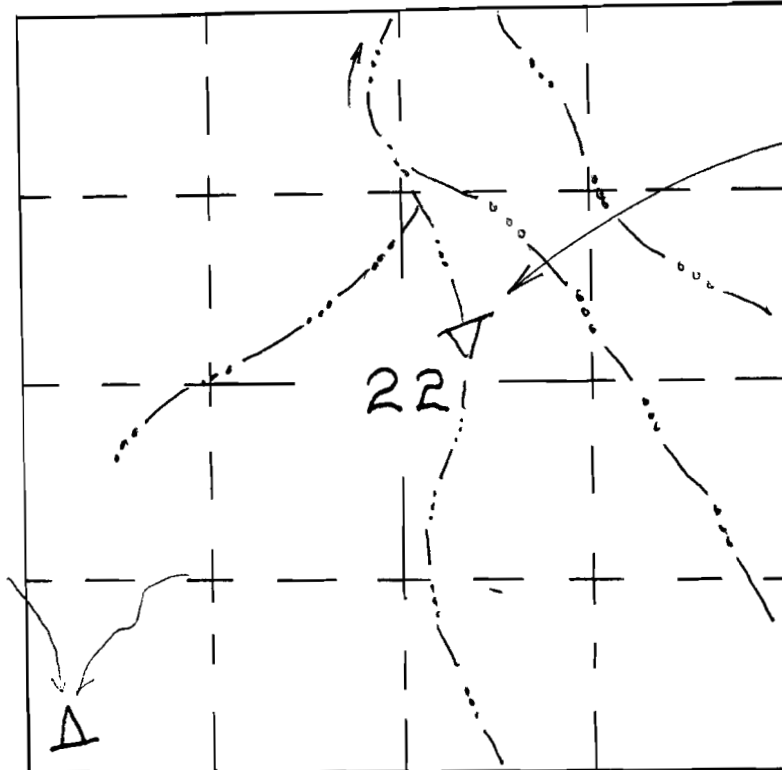

ACTUAL
LOCATION OF
FENCE RES.

Application No. R59086
Permit No. R 8727

U. S. DEPARTMENT OF THE INTERIOR
BUREAU OF LAND MANAGEMENT

FENCE

DESIGNED _____

RECOMM. _____

DRAWN _____

RECOMM. _____

CHIEF, DIV. OF ENG.

CHECKED _____

APPROVED _____

SCALE

DATE

SHEET _____ OF _____

DRAWING NO.