

RECEIVED


AUG - 2 1993

WATER RESOURCES DEPT.
SALEM, OREGON

SECTION 7

~~NW 1/4 NE 1/4~~
4

TOWNSHIP 38^S RANGE 43^E W.M.

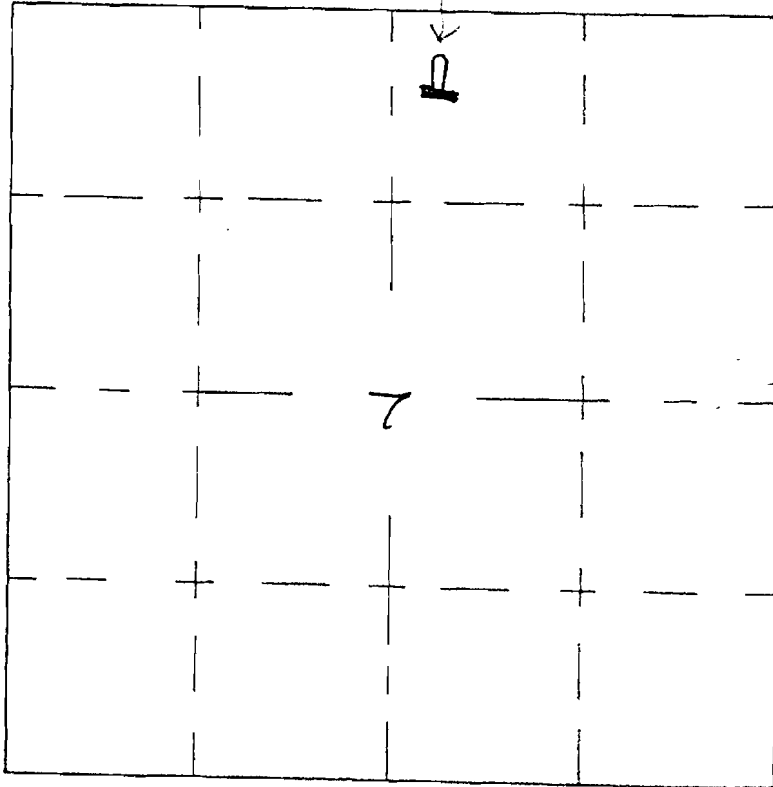

Application No. R59110

Permit No. R 8747

U. S. DEPARTMENT OF THE INTERIOR
BUREAU OF LAND MANAGEMENT

BLUE # 4^{MTN}

DESIGNED _____	RECOMM. _____
DRAWN _____	RECOMM. _____
CHECKED _____	APPROVED _____

CHIEF, DIV. OF ENG.

SCALE _____	
DATE _____	SHEET _____ OF _____
DRAWING NO. _____	

Application No. R-73573

Permit No.

"CERTIFICATE NO. 68938"