

Form AI-187
March 1961

UNITED STATES
DEPARTMENT OF THE INTERIOR
BUREAU OF LAND MANAGEMENT

RECEIVED

AUG - 2 1993


SECTION
31 SESE

Oregon State Water Filings

TOWNSHIP 21 S., RANGE 39 E., W. M.

WATER RESOURCES DEPT.
SALEM, OREGON

North UPPER DEACON RES

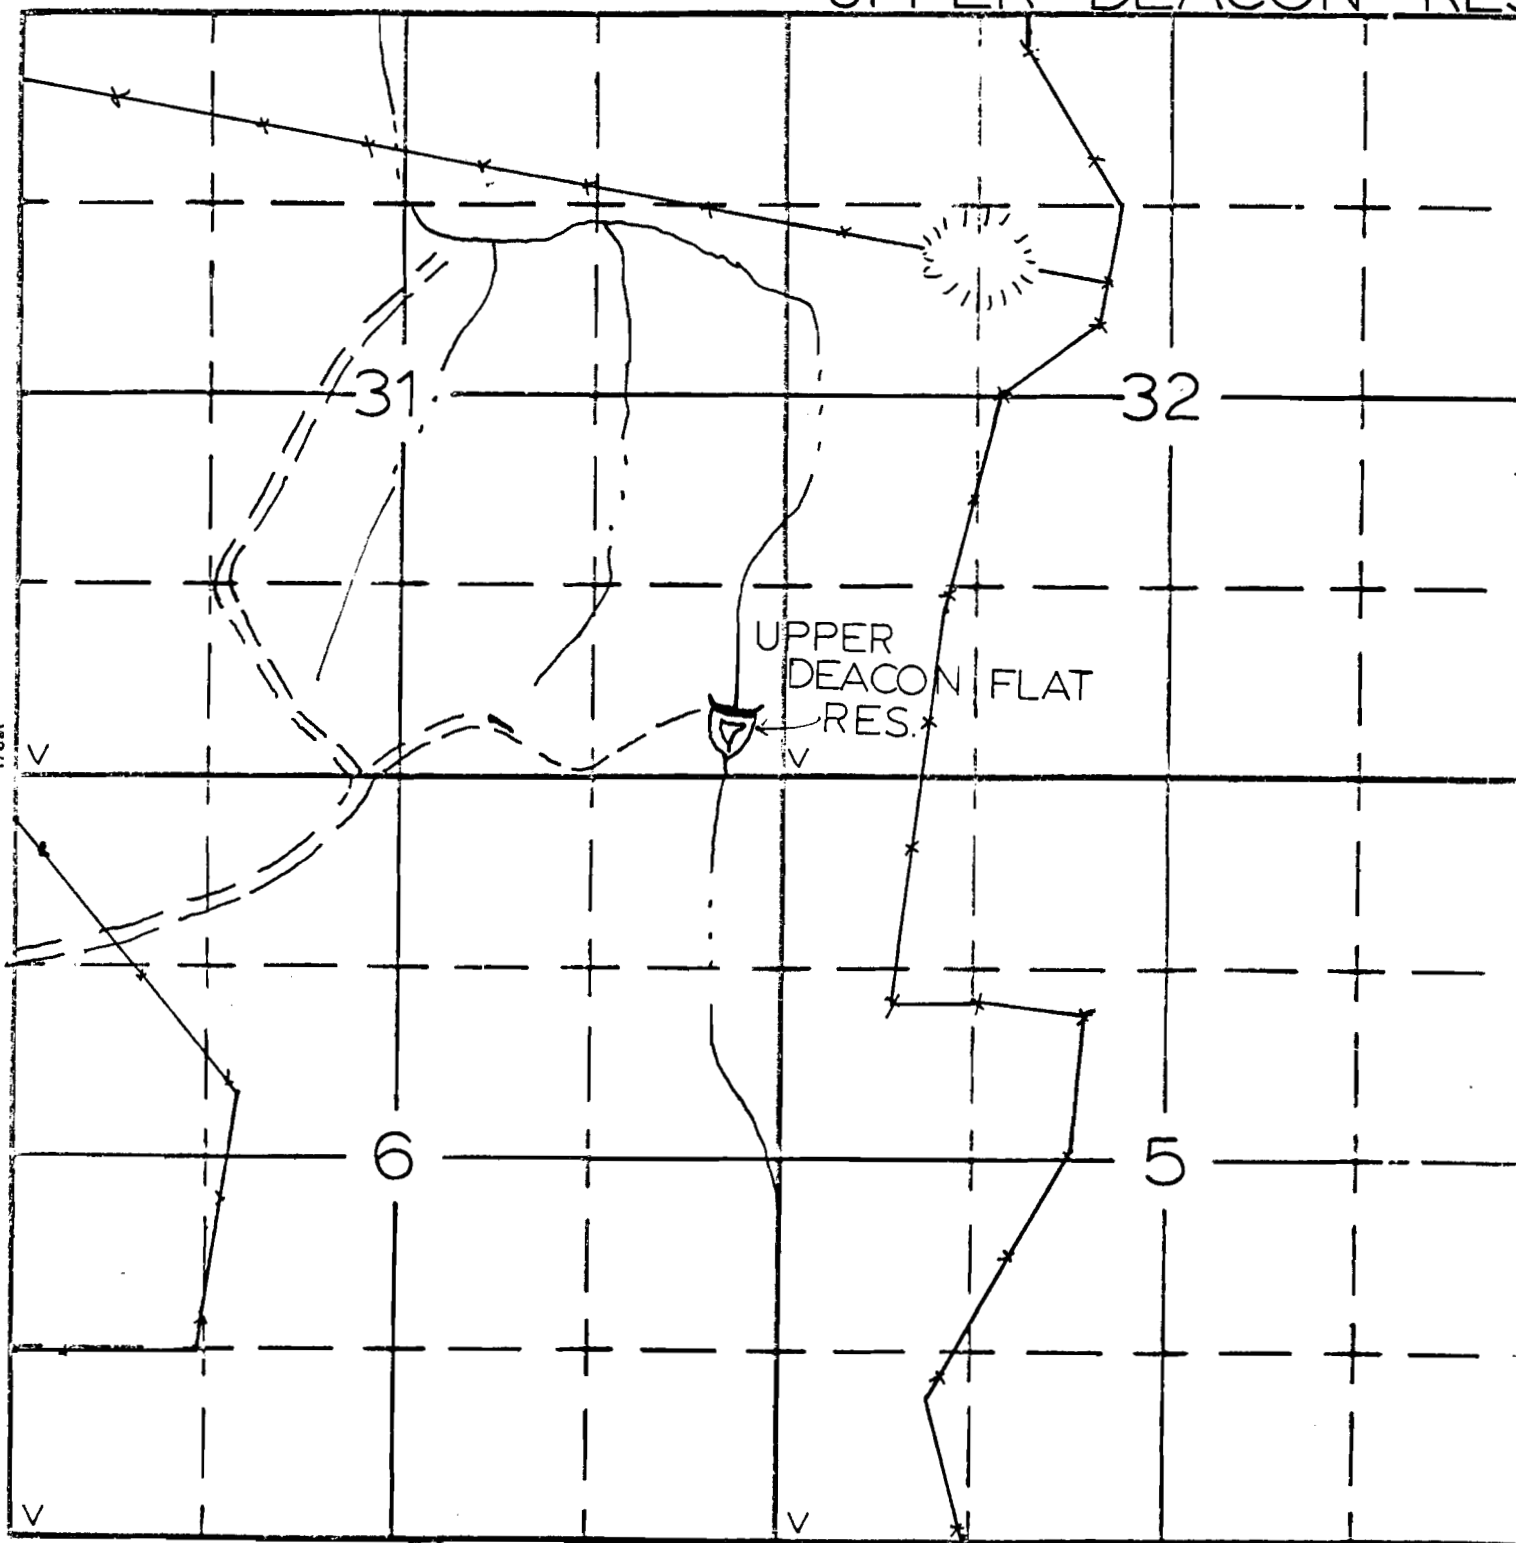

Application No. R-73576 South
75513
Filing No. 68941
STATE NO.

APPLICATION No. R-671
RC7818
DEPOSIT NO. R106