


RECEIVED

AUG - 2 1993

WATER RESOURCES DEPT.
SALEM, OREGON

T. 21 S. R. 40 E. W.M.

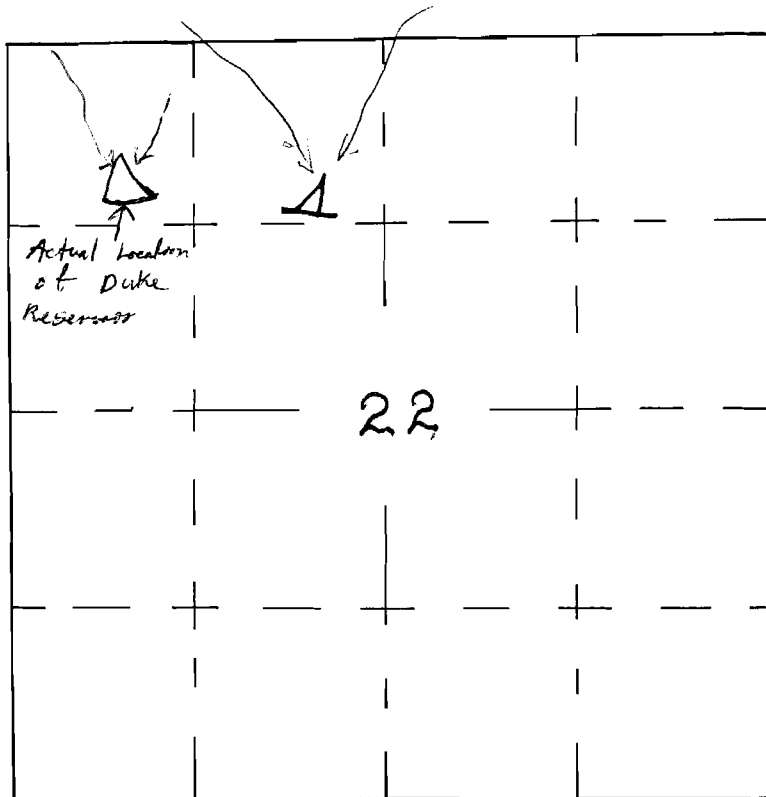

Application No. R59167

Permit No. R 8797

Application No. R-73577
Permit No.

CERTIFICATE NO. 86942

U. S. DEPARTMENT OF THE INTERIOR
BUREAU OF LAND MANAGEMENT

DUKE

DESIGNED _____	RECOMM. _____
DRAWN _____	RECOMM. _____
CHECKED _____	APPROVED _____
SCALE _____	
DATE _____	SHEET _____ OF _____
DRAWING NO. _____	