

RECEIVED

SECTION 32


NOV - 2 1993

NE $\frac{1}{4}$ SE $\frac{1}{4}$

TOWNSHIP 22S RANGE 39E W.M.

ES DEPT.

GON

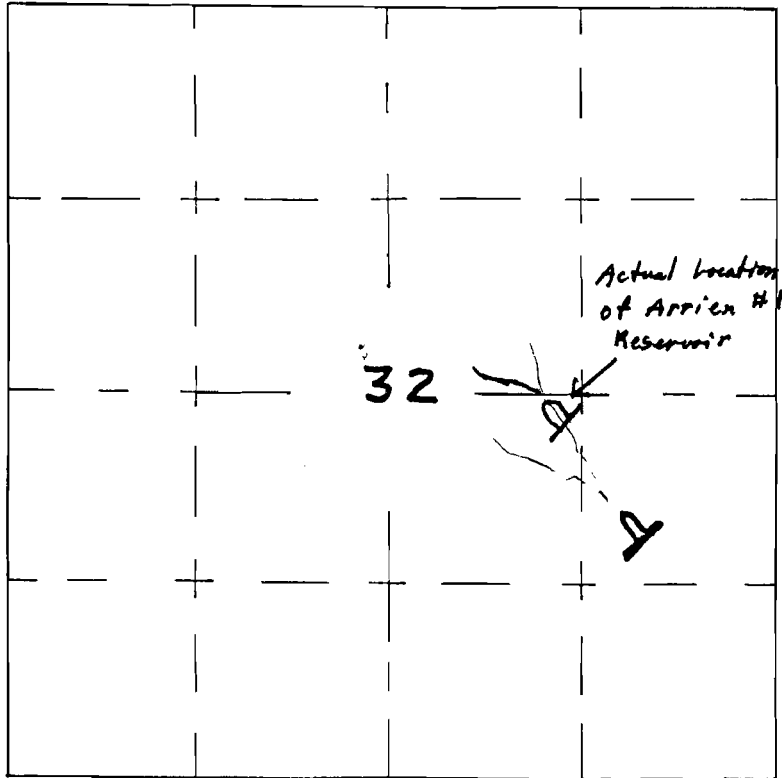

Arrien #1
No R 59114

Permit No. R 8751

Arrien No. R-73578

Arrien No.

Arrien No. 03943