

RECEIVED

SEP 24 1993


WATER RESOURCES DEPT.
SALEM, OREGON

U.S.G.S. QUAD-BOGUS BENCH, OREG. - 7 1/2'



LEGEND

---	TRAIL
==	ROAD
▼	FD SEC COR
◆	FD SEC COR
-----	CREEK

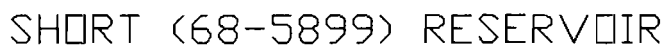


FD STONE
NW COR SEC. 4
T. 29S., R. 42E. W.M.

1320 660 0 1320

SCALE 1"=1320'

THIS MAP IS FOR THE PURPOSE OF LOCATING
A WATER RIGHT AND IS NOT INTENDED TO
PROVIDE LEGAL DIMENSIONS FOR LOCATION
OF PROPERTY BOUNDARIES.

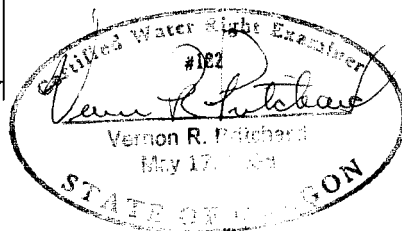

UNITED STATES DEPARTMENT OF THE INTERIOR
BUREAU OF LAND MANAGEMENT
DIVISION OF OPERATIONS VALE DISTRICT

SHORT (68-5899)
RESERVOIR

DESIGNED

REVIEWED

APPROVED

CHIEF, BRANCH OF ENGINEERING

DRAWN: CG

SCALE: 1"=1320'

DATE: 08/31/93

SHEET 1 OF 1

DRAWING NO. OR-03-9172.45-308

ACAD RELEASE 11/DCA
DWG FILE: SHORTA.DWG

***CERTIFICATE NO.**

R-73647

62492