

Form AI-187
March 1961

UNITED STATES
DEPARTMENT OF THE INTERIOR
BUREAU OF LAND MANAGEMENT

SECTION

15 NENW

Oregon State Water Filings

TOWNSHIP 17 S, RANGE 43 E, W. M.


HOPE FLAT RES

RECEIVED

SEP 30 1993

WATER RESOURCES DEPT.
SALEM, OREGON

North

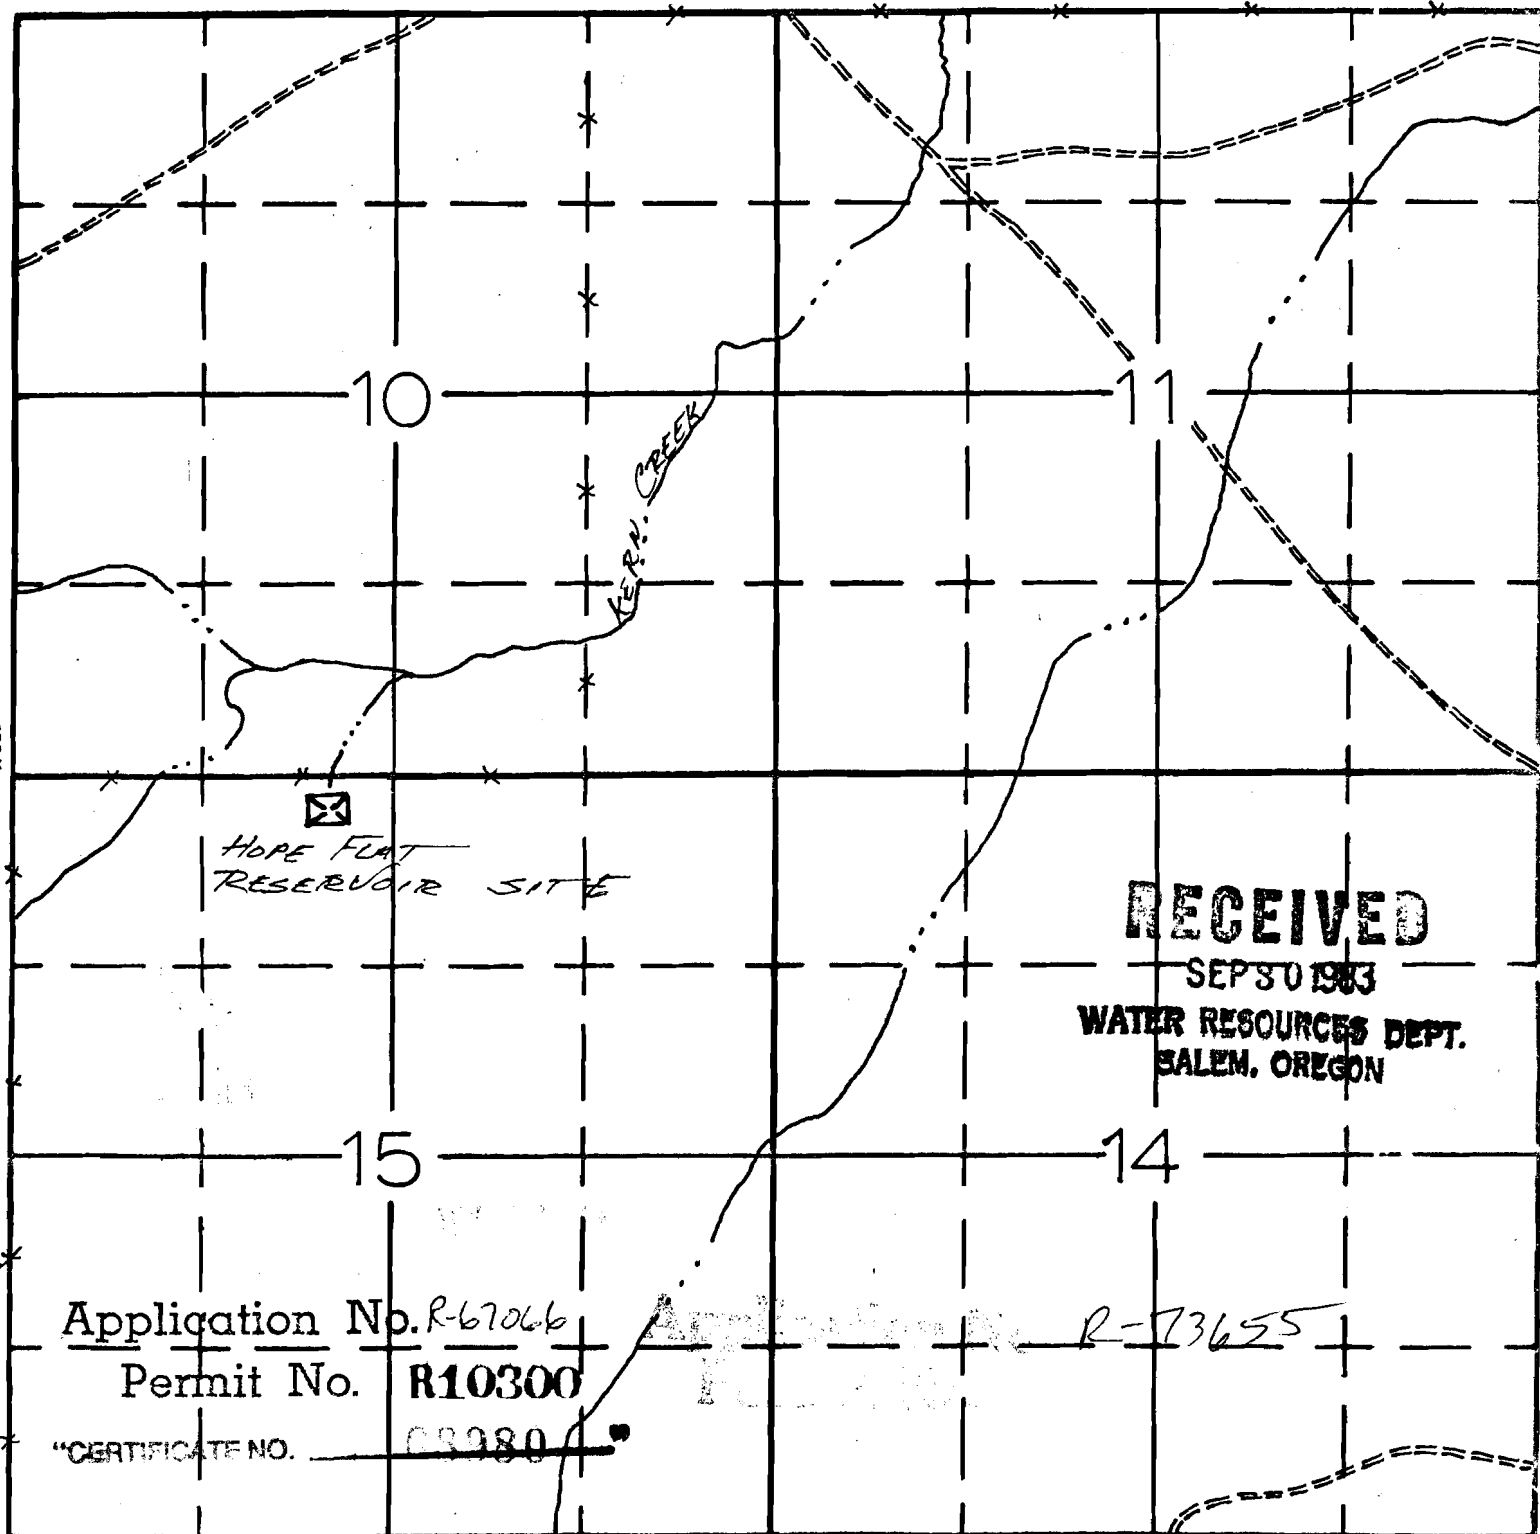

RECEIVED

SEP 30 1993

WATER RESOURCES DEPT.
SALEM, OREGON

Application No. R-67066

Permit No. R10300


R-73655

DRAWN J A 7-83

South

APPLICATION No.

PERMIT No.