

UNITED STATES
DEPARTMENT OF THE INTERIOR
BUREAU OF LAND MANAGEMENT

SECTION


Oregon State Water Filings

S28

TOWNSHIP 31S, RANGE 43E, W. M.

RECEIVED
SEP 20 1993
WATER RESOURCES DEPT.
SALEM, OREGON

North

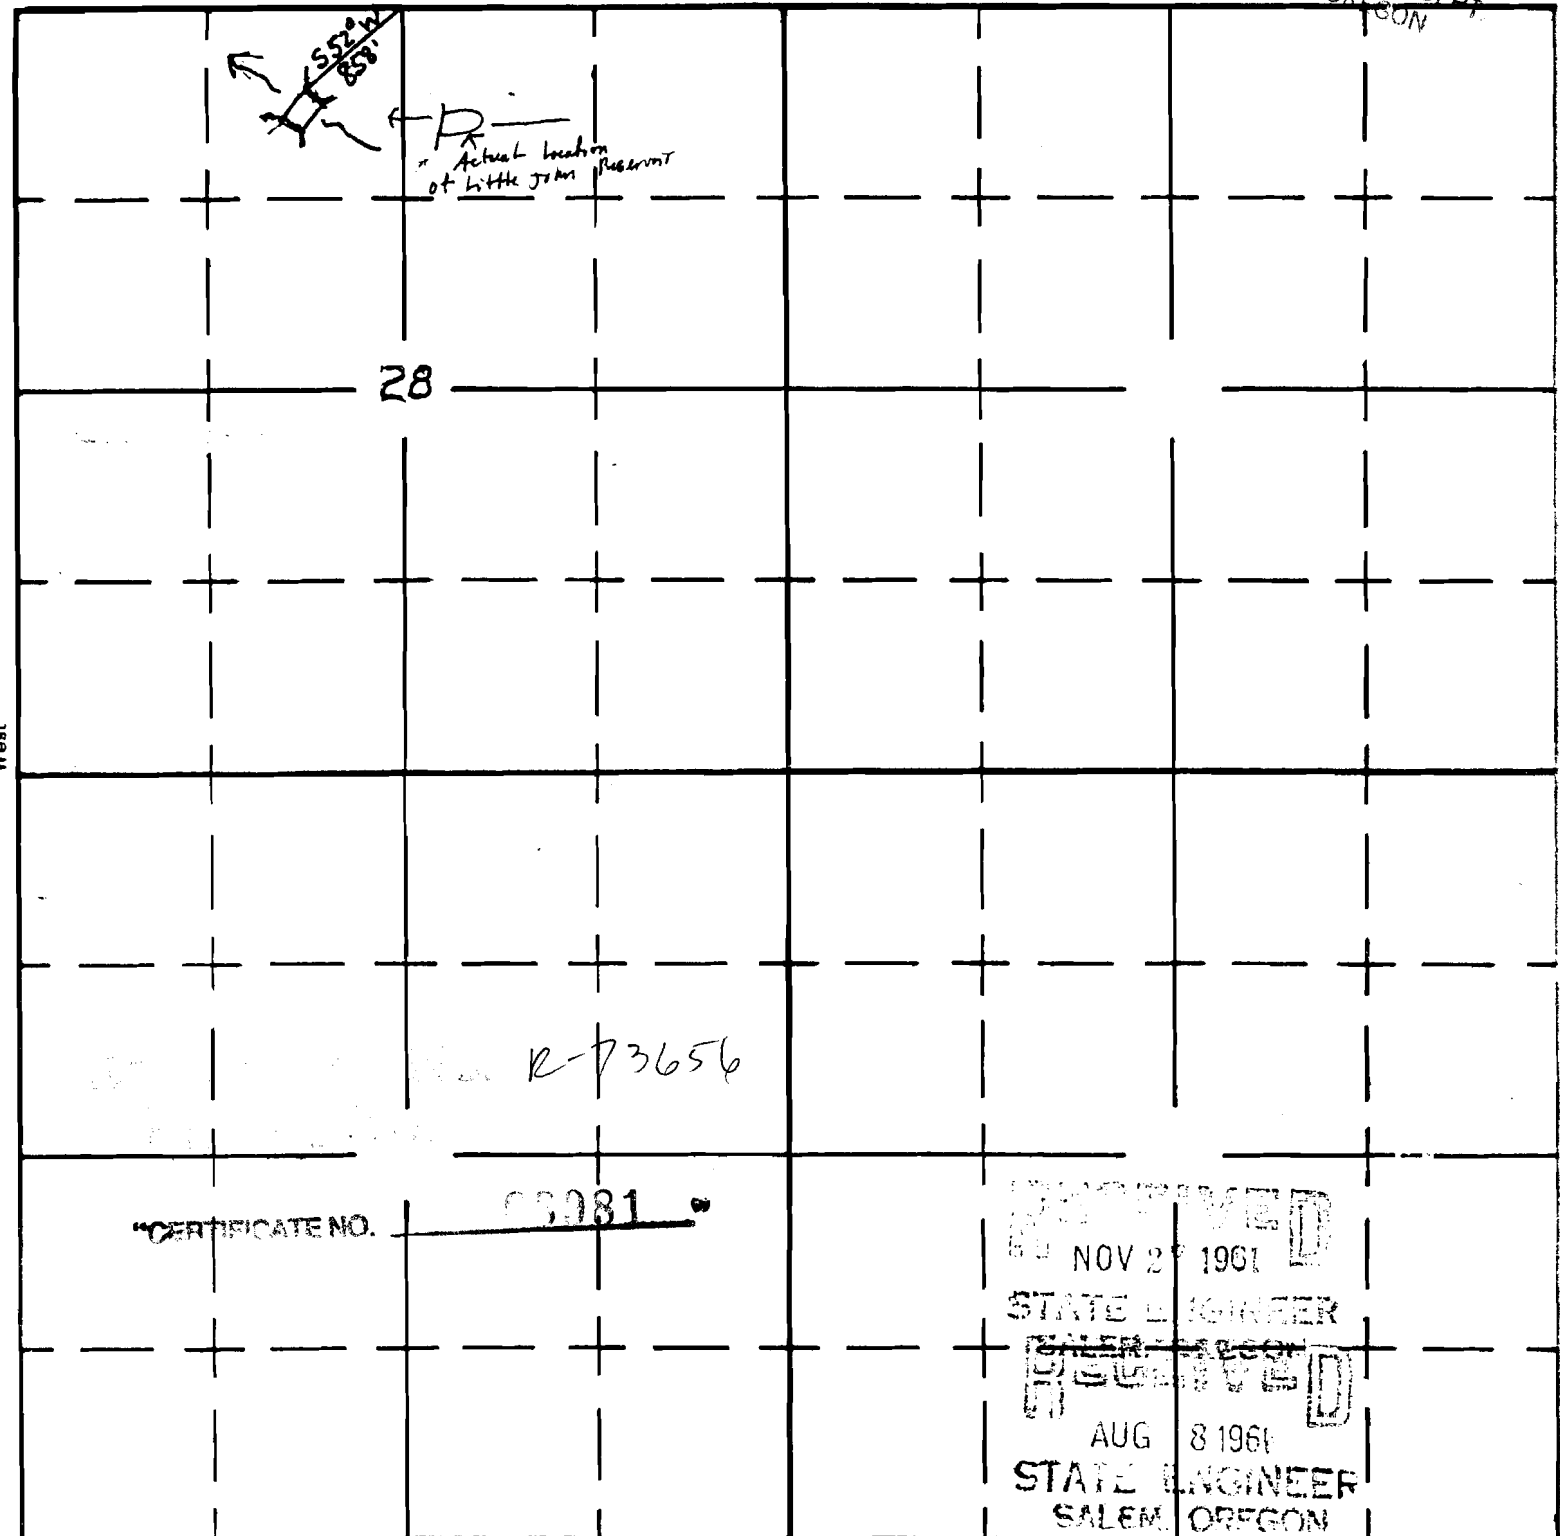

West

28

Actual location
of Little John Reservoir

R-73656

CERTIFICATE NO.


RECEIVED
NOV 27 1961
STATE ENGINEER
SALEM, OREGON
RECEIVED
AUG 8 1961
STATE ENGINEER
SALEM, OREGON

South

APPLICATION No. R-3661
PERMIT No. R-351