


12-73690
"CERTIFICATE NO. 0005"
T. 40 S., R. 4 E., W.M.

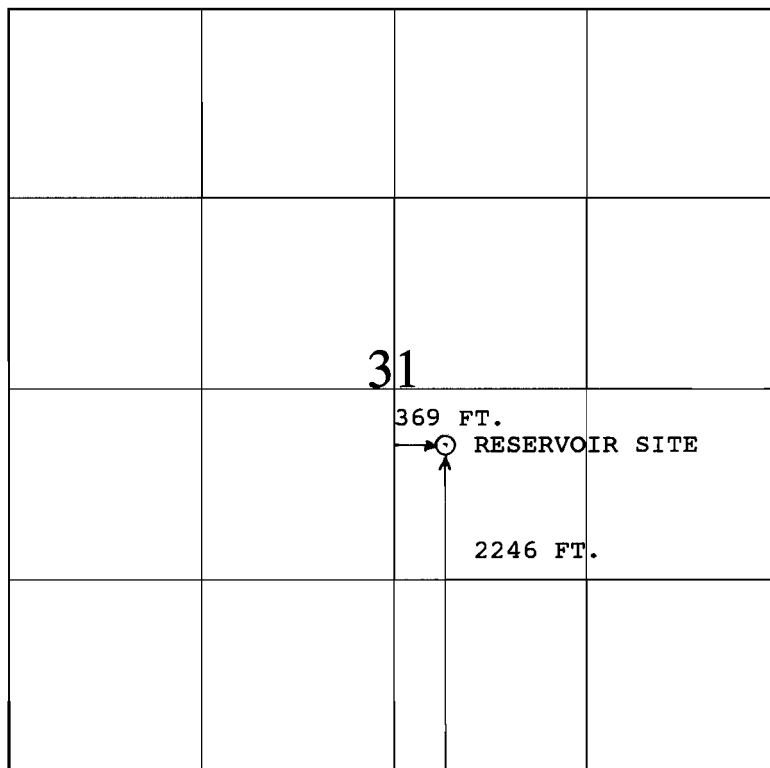


1 IN. = 1320 FT.

IRON PIPE AND
BRASS CAP

APPLICATION MAP

FOR

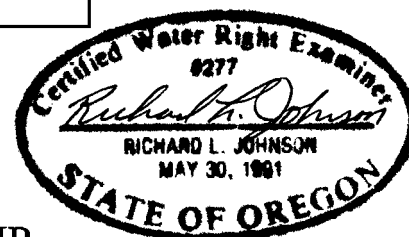

RECEIVED

OCT 01 1993

DEAD HORSE SPRING, RESERVOIR

WATER RESOURCES DEPT.
SALEM, OREGON

IN NAME OF

UNITED STATES BUREAU OF LAND MANAGEMENT

MAY 3, 1993

THE PURPOSE OF THIS MAP IS FOR IDENTIFYING THE LOCATION OF THE WATER RIGHT ONLY AND
IS NOT INTENDED TO PROVIDE LEGAL DIMENSIONS OR LOCATION OF PROPERTY OWNERSHIP LINES.

WRE 6071A OREGON


U.S. BUREAU OF LAND MANAGEMENT - OSO
BRANCH OF CADASTRAL SURVEY

EXECUTED BY:
RICHARD L. JOHNSON, PLS, CWRE

LETTER OF AUTHORIZATION
DATED: JUNE 14, 1993

OR-942.1
P.O. BOX 2965
PORTLAND OR., 97208

Public No. R-73690
Public No. 6005
T. 41 S., R. 4 E., W.M.

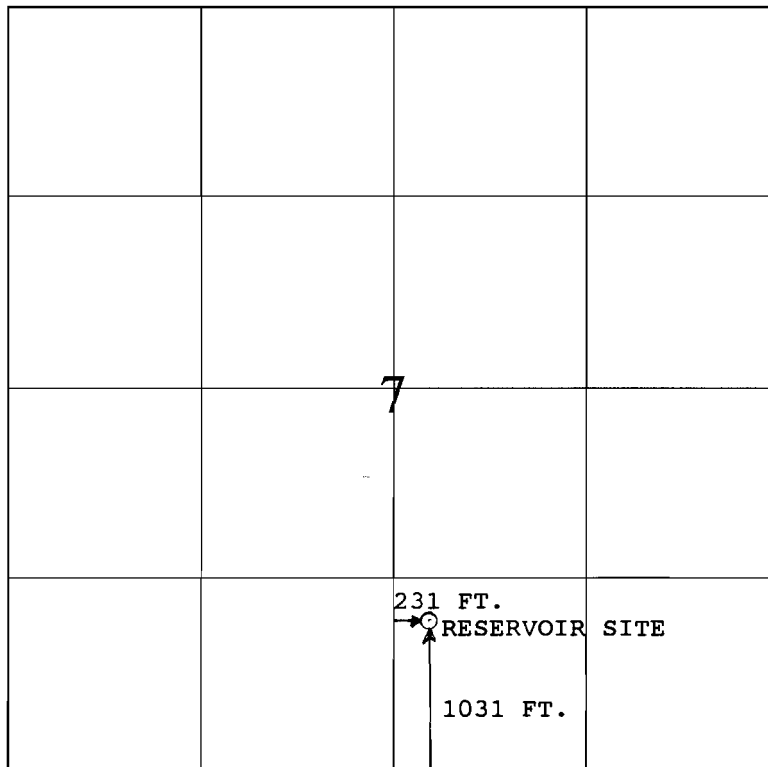

1 IN. = 1320 FT.

RECEIVED

OCT 01 1993

WATER RESOURCES DEPT.
SALEM, OREGON

APPLICATION MAP

FOR

BEAR WALLOW


IN NAME OF

UNITED STATES BUREAU OF LAND MANAGEMENT

MAY 10, 1993

THE PURPOSE OF THIS MAP IS FOR IDENTIFYING THE LOCATION OF THE WATER RIGHT ONLY AND
IS NOT INTENDED TO PROVIDE LEGAL DIMENSIONS OR LOCATION OF PROPERTY OWNERSHIP LINES.

WRE 6052A OREGON

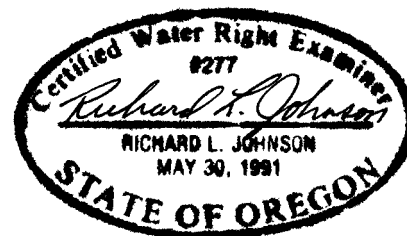

U.S. BUREAU OF LAND MANAGEMENT - OSO
BRANCH OF CADASTRAL SURVEY

LETTER OF AUTHORIZATION
DATED: MAY 3, 1993

EXECUTED BY:
RICHARD L. JOHNSON, PLS, CWRE

OR-942.1
P.O. BOX 2965
PORTLAND OR., 97208

No. 273690

No.


"CERTIFICATE NO.

0005

T. 41 S., R. 4 E., W.M.

IRON PIPE AND
BRASS CAP

RESERVOIR SITE

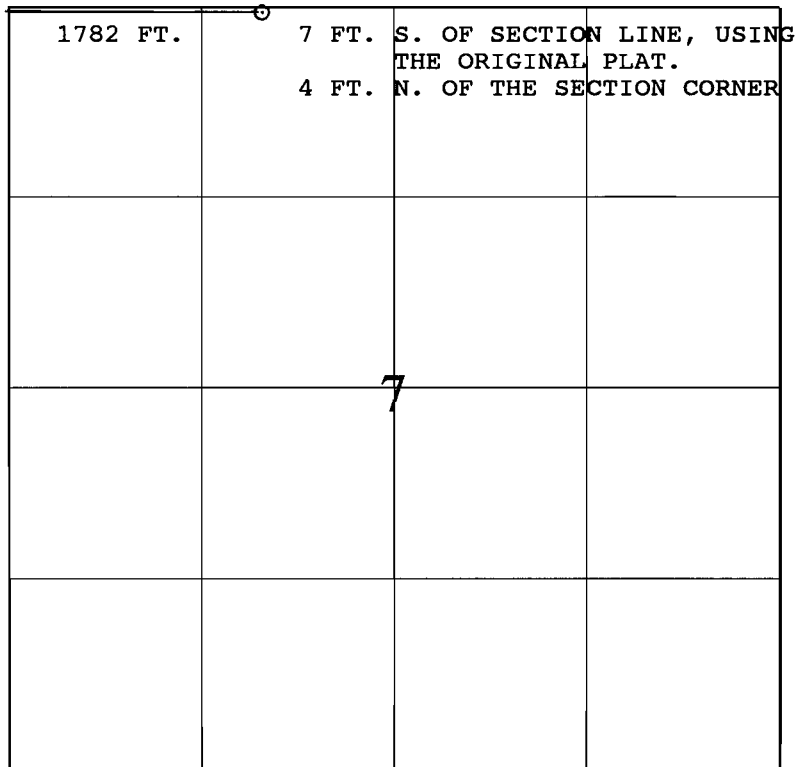

1 IN. = 1320 FT.

RECEIVED

OCT 01 1993

WATER RESOURCES DEPT.
SALEM, OREGON

APPLICATION MAP

FOR

WILLOW POND


IN NAME OF

UNITED STATES BUREAU OF LAND MANAGEMENT

MAY 25, 1993

THE PURPOSE OF THIS MAP IS FOR IDENTIFYING THE LOCATION OF THE WATER RIGHT ONLY AND
IS NOT INTENDED TO PROVIDE LEGAL DIMENSIONS OR LOCATION OF PROPERTY OWNERSHIP LINES.

WRE 6054A OREGON

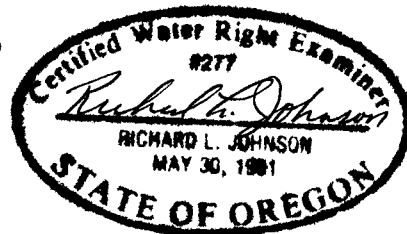

U.S. BUREAU OF LAND MANAGEMENT - OSO
BRANCH OF CADASTRAL SURVEY

LETTER OF AUTHORIZATION
DATED: MAY 3, 1993

EXECUTED BY:
RICHARD L. JOHNSON, PLS, CWRE

OR-942.1
P.O. BOX 2965
PORTLAND OR., 97208

Plan No. R-73690


No.

"CERTIFICATE NO.

00005

99.

T. 41 S., R. 4 E., W.M.

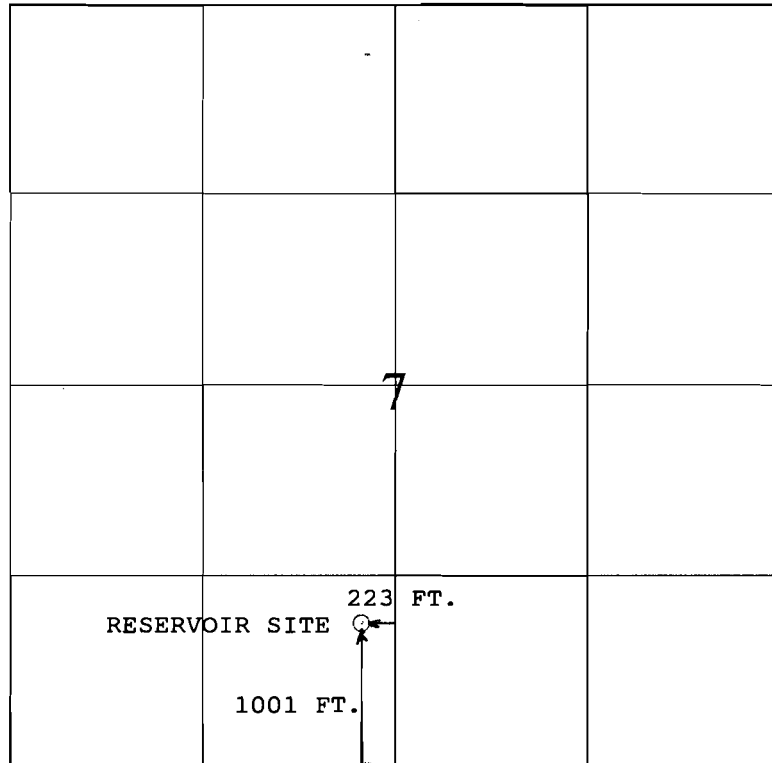

1 IN. = 1320 FT.

RECEIVED

OCT 01 1993

**WATER RESOURCES DEPT.
SALEM, OREGON**

APPLICATION MAP

FOR

STATELINE WATER HOLE


IN NAME OF

UNITED STATES BUREAU OF LAND MANAGEMENT

MAY 25, 1993

THE PURPOSE OF THIS MAP IS FOR IDENTIFYING THE LOCATION OF THE WATER RIGHT ONLY AND
IS NOT INTENDED TO PROVIDE LEGAL DIMENSIONS OR LOCATION OF PROPERTY OWNERSHIP LINES.

WRE 6053A OREGON

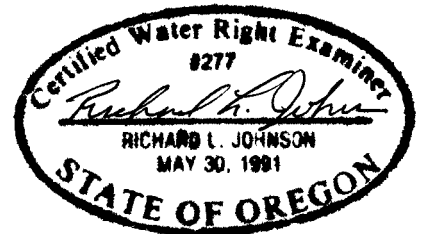

U.S. BUREAU OF LAND MANAGEMENT - OSO
BRANCH OF CADASTRAL SURVEY

LETTER OF AUTHORIZATION
DATED: MAY 3, 1993

EXECUTED BY:
RICHARD L. JOHNSON, PLS, CWRE



OR-942.1
P.O. BOX 2965
PORTLAND OR., 97208

NO. R-73690

"CERTIFICATE NO. 7005"

T. 41 S., R. 4 E., W.M.

IRON PIPE AND
BRASS CAP

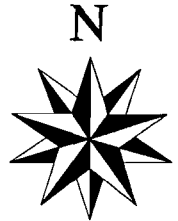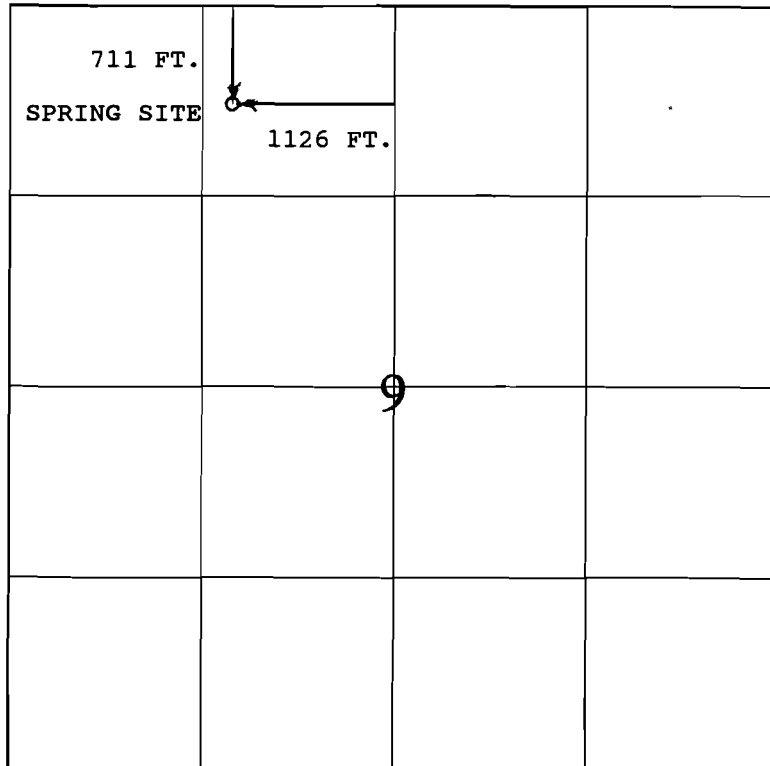

1 IN. = 1320 FT.

APPLICATION MAP


FOR

JENNY CREEK SPRING

IN NAME OF

RECEIVED
OCT 01 1993
WATER RESOURCES DIVISION
SALEM, OREGON

UNITED STATES BUREAU OF LAND MANAGEMENT

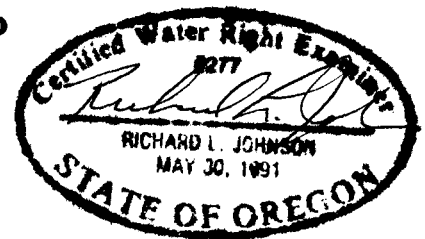

JUNE 14, 1993

THE PURPOSE OF THIS MAP IS FOR IDENTIFYING THE LOCATION OF THE WATER RIGHT ONLY AND
IS NOT INTENDED TO PROVIDE LEGAL DIMENSIONS OR LOCATION OF PROPERTY OWNERSHIP LINES.

WRE 6070A OREGON


U.S. BUREAU OF LAND MANAGEMENT - OSO
BRANCH OF CADASTRAL SURVEY

EXECUTED BY:
RICHARD L. JOHNSON, PLS, CWRE

LETTER OF AUTHORIZATION
DATED: JUNE 14, 1993


OR-942.1
P.O. BOX 2965
PORTLAND OR., 97208

12-73690
"CERTIFICATE NO. 1005"
T. 40 S., R. 4 E., W.M.

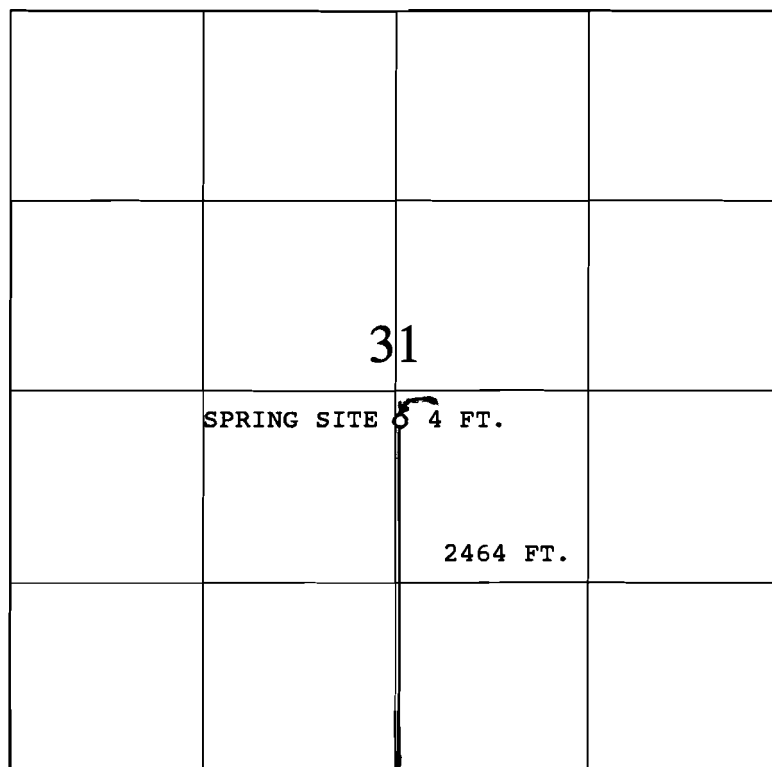

1 IN. = 1320 FT.

IRON PIPE AND
BRASS CAP
APPLICATION MAP

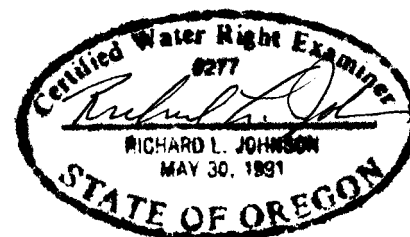

RECEIVED

OCT 01 1993

WATER RESOURCES DEPT
SALEM, OREGON

FOR

DEAD HORSE SPRING

IN NAME OF

UNITED STATES BUREAU OF LAND MANAGEMENT

JUNE 14, 1993

THE PURPOSE OF THIS MAP IS FOR IDENTIFYING THE LOCATION OF THE WATER RIGHT ONLY AND
IS NOT INTENDED TO PROVIDE LEGAL DIMENSIONS OR LOCATION OF PROPERTY OWNERSHIP LINES.

WRE 6072A OREGON

U.S. BUREAU OF LAND MANAGEMENT - OSO
BRANCH OF CADASTRAL SURVEY

EXECUTED BY:
RICHARD L. JOHNSON, PLS, CWRE

LETTER OF AUTHORIZATION
DATED: JUNE 28, 1993

OR-942.1
P.O. BOX 2965
PORTLAND OR., 97208