

R-73709

Permit No.

CERTIFICATE NO. 0018

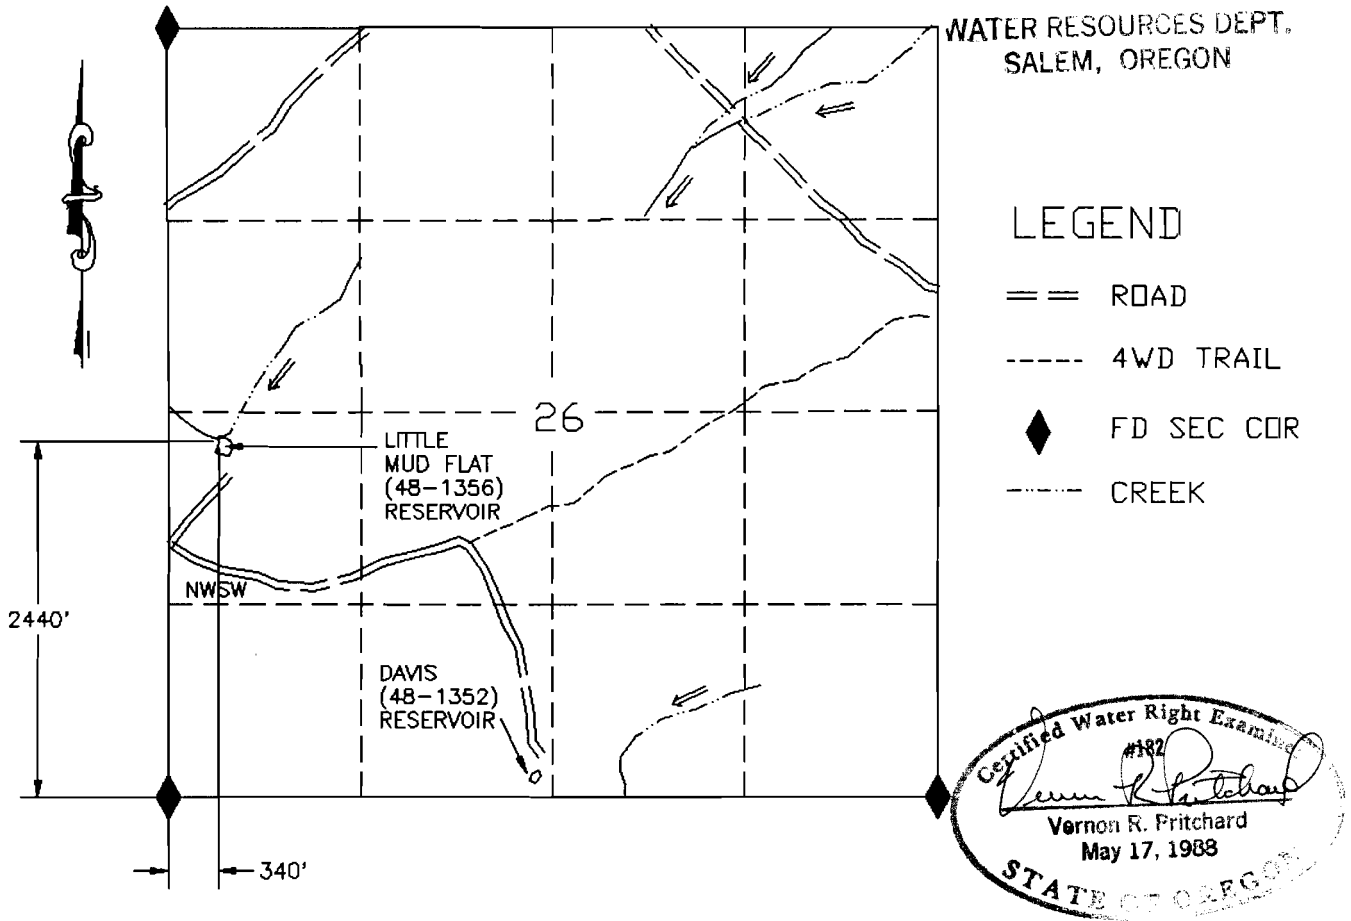
APPLICATION MAP FOR PERMIT TO CONSTRUCT A RESERVOIR

NW1/4 SW1/4 SEC 26 T 25S R 42E W.M.

U.S.G.S. QUAD - BIG MUD FLAT, OREG. - 7 1/2'

RECEIVED

OCT 04 1993

WATER RESOURCES DEPT.
SALEM, OREGON

LITTLE MUD FLAT (48-1356) RESERVOIR

1320 660 0 1320

SCALE 1"=1320'

THIS MAP IS FOR THE PURPOSE OF LOCATING
A WATER RIGHT AND IS NOT INTENDED TO
PROVIDE LEGAL DIMENSIONS FOR LOCATION
OF PROPERTY BOUNDARIES.



ACAD RELEASE 11/DCA
DWG FILE: LMUDFLT.DWG

UNITED STATES DEPARTMENT OF THE INTERIOR
BUREAU OF LAND MANAGEMENT
DIVISION OF OPERATIONS VALE DISTRICT

LITTLE MUD FLAT
(48-1356) RESERVOIR

DESIGNED

REVIEWED

APPROVED

CHIEF, BRANCH OF ENGINEERING

DRAWN: CG

SCALE: 1"=1320'

DATE: 09/10/93

SHEET 1 OF 1

DRAWING NO. OR-03-9172.45-400