


APPLICATION MAP FOR PERMIT TO CONSTRUCT A RESERVOIR


SE 1/4 NE 1/4 SEC 23 T 10S R 42E W.M.

U.S.G.S. QUAD - OXMAN, OREG. - 7 1/2'

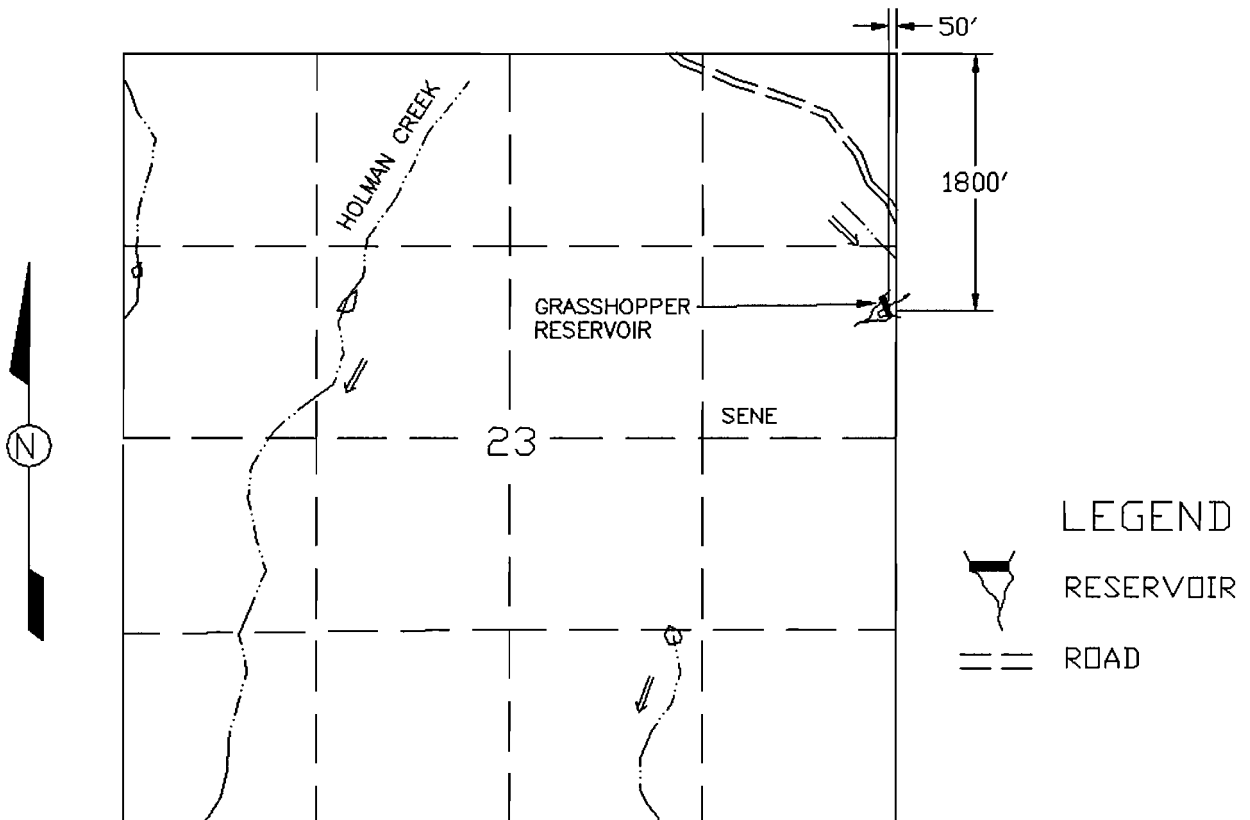


1320 660 0 1320
SCALE 1"=1320'

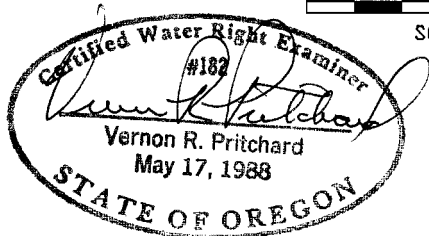

THIS MAP IS FOR THE PURPOSE OF LOCATING A WATER RIGHT AND IS NOT INTENDED TO PROVIDE LEGAL DIMENSIONS FOR LOCATION OF PROPERTY BOUNDARIES.

ACAD RELEASE 11/04
DWG FILE: GRASSHPR.DWG

UNITED STATES DEPARTMENT OF THE INTERIOR BUREAU OF LAND MANAGEMENT DIVISION OF OPERATIONS VALE DISTRICT	
GRASSHOPPER (58-4461) RESERVOIR	
DESIGNED	<i>Vernon R. Pritchard</i> <i>George D. House</i> CHIEF, BRANCH OF ENGINEERING
REVIEWED	
APPROVED	
DRAWN: CG	SCALE: 1"=1320'
DATE: 04/23/93	SHEET 1 OF 1
DRAWING NO. OR-03-9172.45-253	

Application No. R-73774

Permit No.


"CERTIFICATE NO. 1035"

APPLICATION MAP FOR PERMIT TO CONSTRUCT A RESERVOIR

SE1/4 NW1/4 SEC 23 T 10S R 42E W.M.

U.S.G.S. QUAD - OXMAN, OREG. - 7 1/2'



0308
Dated 8-1-93

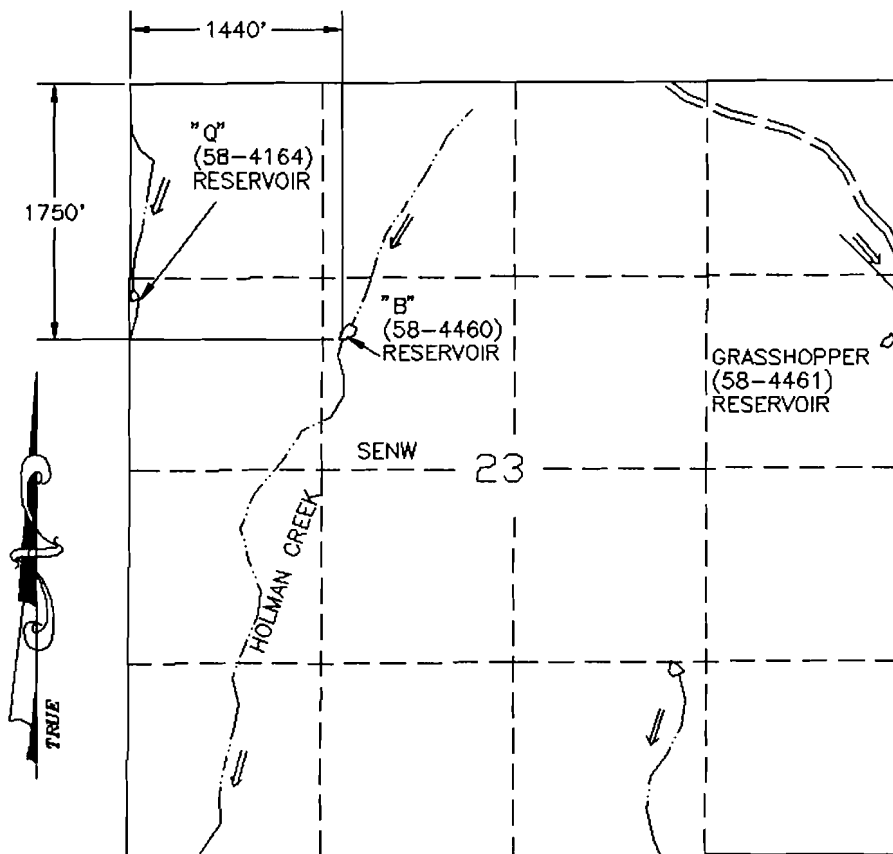

LEGEND

- △ RESERVOIR
- == ROAD
- CHANNEL

"B" (58-4460) RESERVOIR

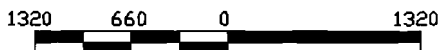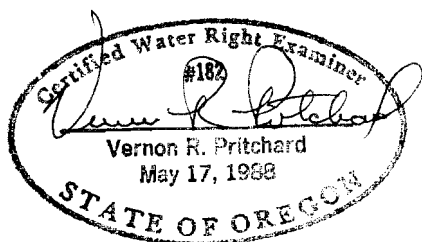

SCALE 1"=1320'

THIS MAP IS FOR THE PURPOSE OF LOCATING A WATER RIGHT AND IS NOT INTENDED TO PROVIDE LEGAL DIMENSIONS FOR LOCATION OF PROPERTY BOUNDARIES.



ACAD RELEASE 11/DCA
DWG FILE: BRES.DWG

UNITED STATES DEPARTMENT OF THE INTERIOR
BUREAU OF LAND MANAGEMENT
DIVISION OF OPERATIONS VALE DISTRICT

"B" (58-4460)
RESERVOIR

DESIGNED
REVIEWED *Vernon R. Pritchard*
APPROVED *George D. House*
CHIEF, BRANCH OF ENGINEERING

DRAWN: CG SCALE: 1"=1320'
DATE: 09/21/93 SHEET 1 OF 1
DRAWING NO. OR-03-9172.45-432

Application No. R-73776


Permit No.

CERTIFICATE NO. 03085


APPLICATION MAP FOR PERMIT TO CONSTRUCT A RESERVOIR

NW1/4 NW1/4 SEC 35 T 10S R 42E W.M.

U.S.G.S. QUAD - OXMAN, OREG. - 7 1/2'

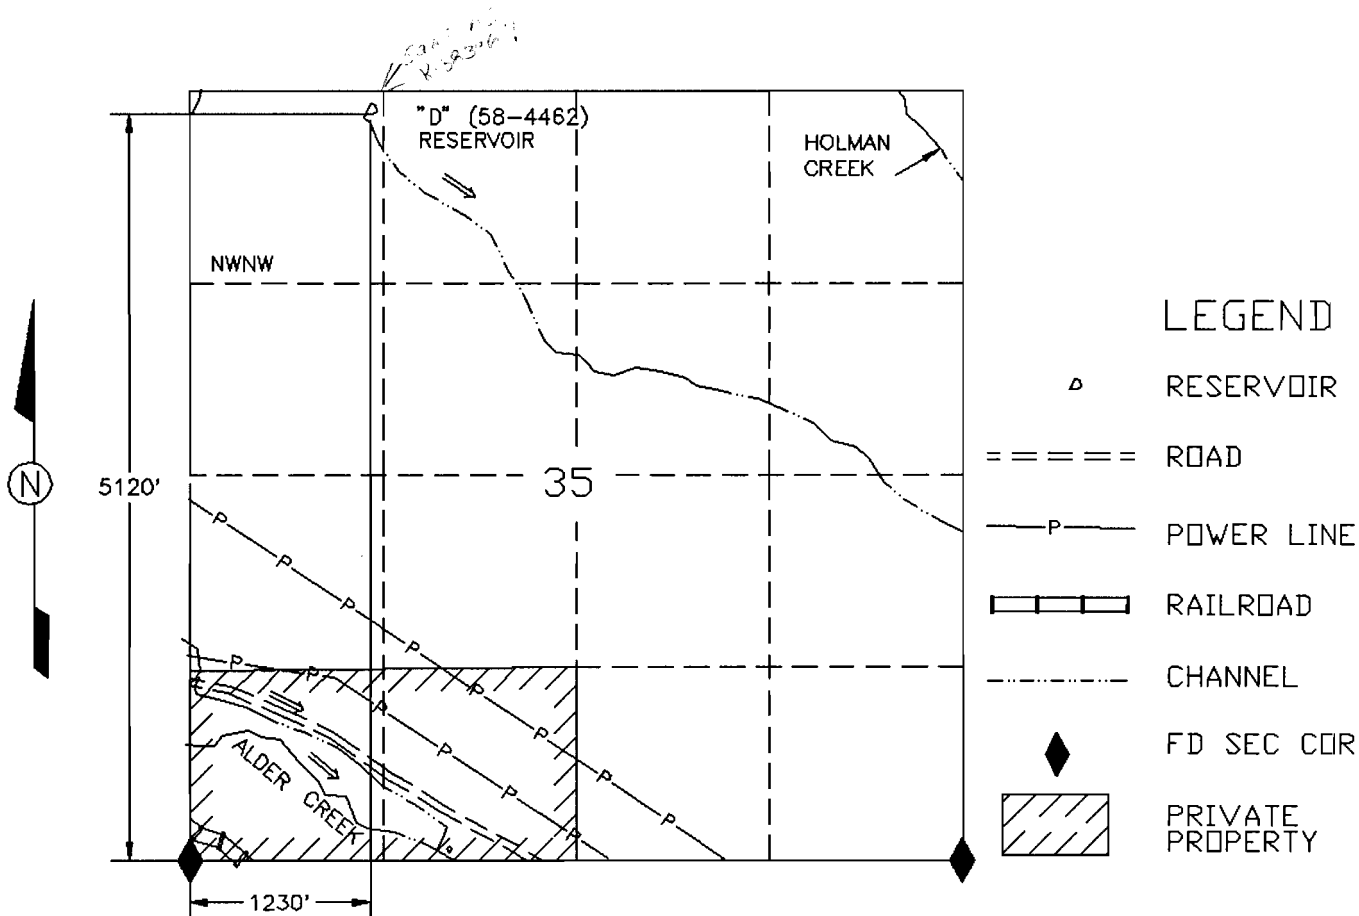

"D" (58-4462) RESERVOIR

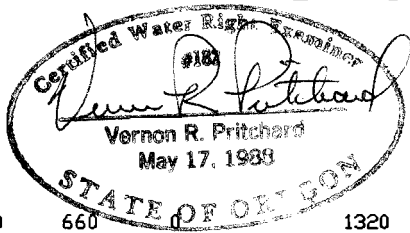

SCALE 1"=1320'

THIS MAP IS FOR THE PURPOSE OF LOCATING A WATER RIGHT AND IS NOT INTENDED TO PROVIDE LEGAL DIMENSIONS FOR LOCATION OF PROPERTY BOUNDARIES.



ACAD RELEASE 11/DCA
DWG FILE: D-RES.DWG

UNITED STATES DEPARTMENT OF THE INTERIOR BUREAU OF LAND MANAGEMENT DIVISION OF OPERATIONS VALE DISTRICT	
"D" (58-4462) RESERVOIR	
DESIGNED	<i>Vernon R. Pritchard</i>
REVIEWED	<i>Vernon R. Pritchard</i>
APPROVED	<i>Vernon R. Pritchard</i>
CHIEF, BRANCH OF ENGINEERING	
DRAWN: CG	SCALE: 1"=1320'
DATE: 09/21/93	SHEET 1 OF 1
DRAWING NO. OR-03-9172.45-431	

Application No. R-73776


Permit No.

CERTIFICATE NO. 00035

APPLICATION MAP FOR PERMIT TO CONSTRUCT A RESERVOIR


NE1/4 SE1/4 SEC 16 T 10S R 42E W.M.

U.S.G.S. QUAD - OXMAN, OREG. - 7 1/2'

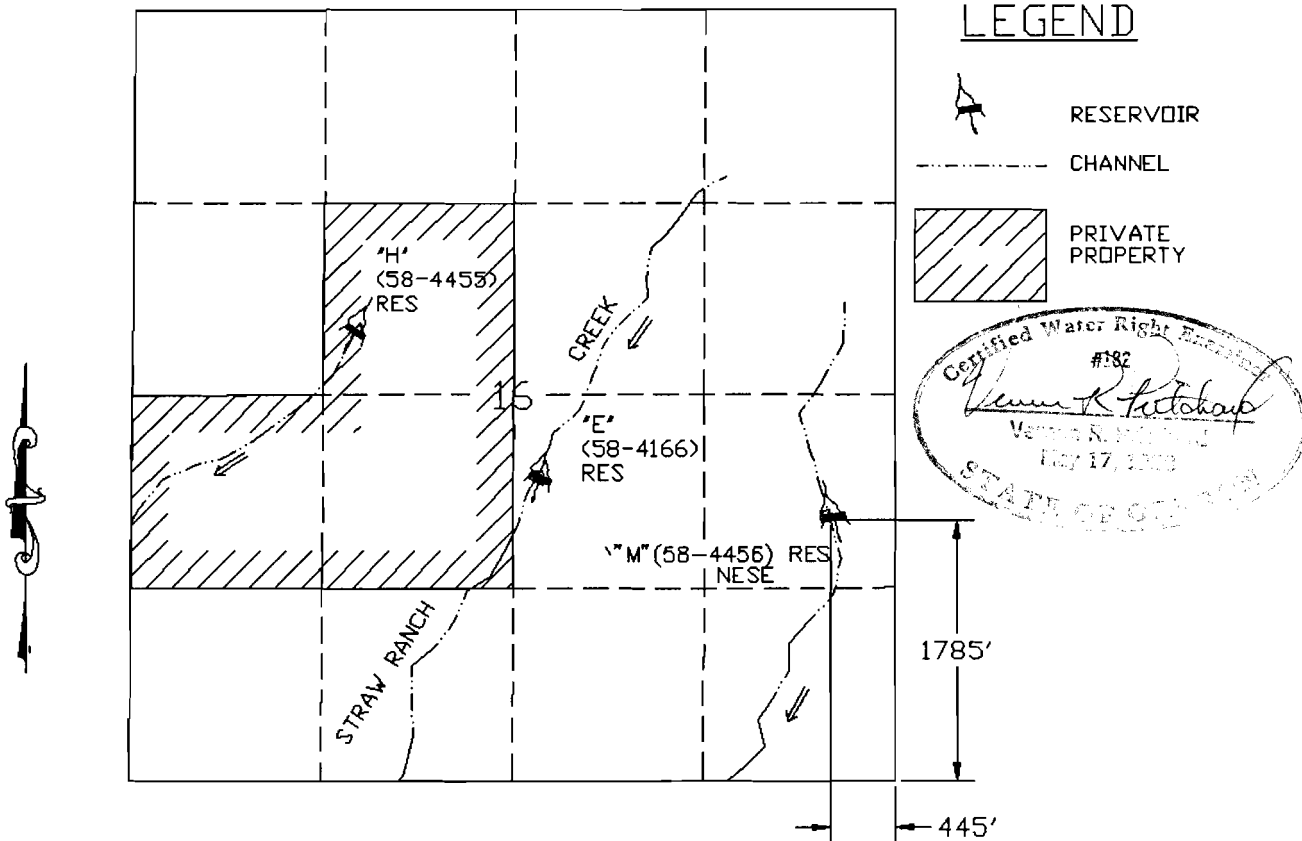

"M" (58-4456) RESERVOIR

OVERALL DIMENSIONS OF THIS SECTION
ARE FROM THE ORIGINAL CADASTRAL
SURVEY FIELD NOTES.

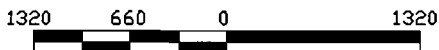

SCALE 1"=1320'

THIS MAP IS FOR THE PURPOSE OF LOCATING
A WATER RIGHT AND IS NOT INTENDED TO
PROVIDE LEGAL DIMENSIONS FOR LOCATION
OF PROPERTY BOUNDARIES.



UNITED STATES DEPARTMENT OF THE INTERIOR
BUREAU OF LAND MANAGEMENT
DIVISION OF OPERATIONS VALE DISTRICT

"M" (58-4456) RESERVOIR

DESIGNED

REVIEWED

APPROVED

Vernon R. Kitchin
George R. House
CHIEF, BRANCH OF ENGINEERING

DRAWN:

CG

SCALE: 1"=1320'

DATE:

08/23/93

SHEET 1 OF 1

DRAWING NO.

OR-03-9172.45-361

ACAD RELEASE 11/DCA
DWG FILE: MRES.DWG

Application No. R-73774
Permit No.

00035