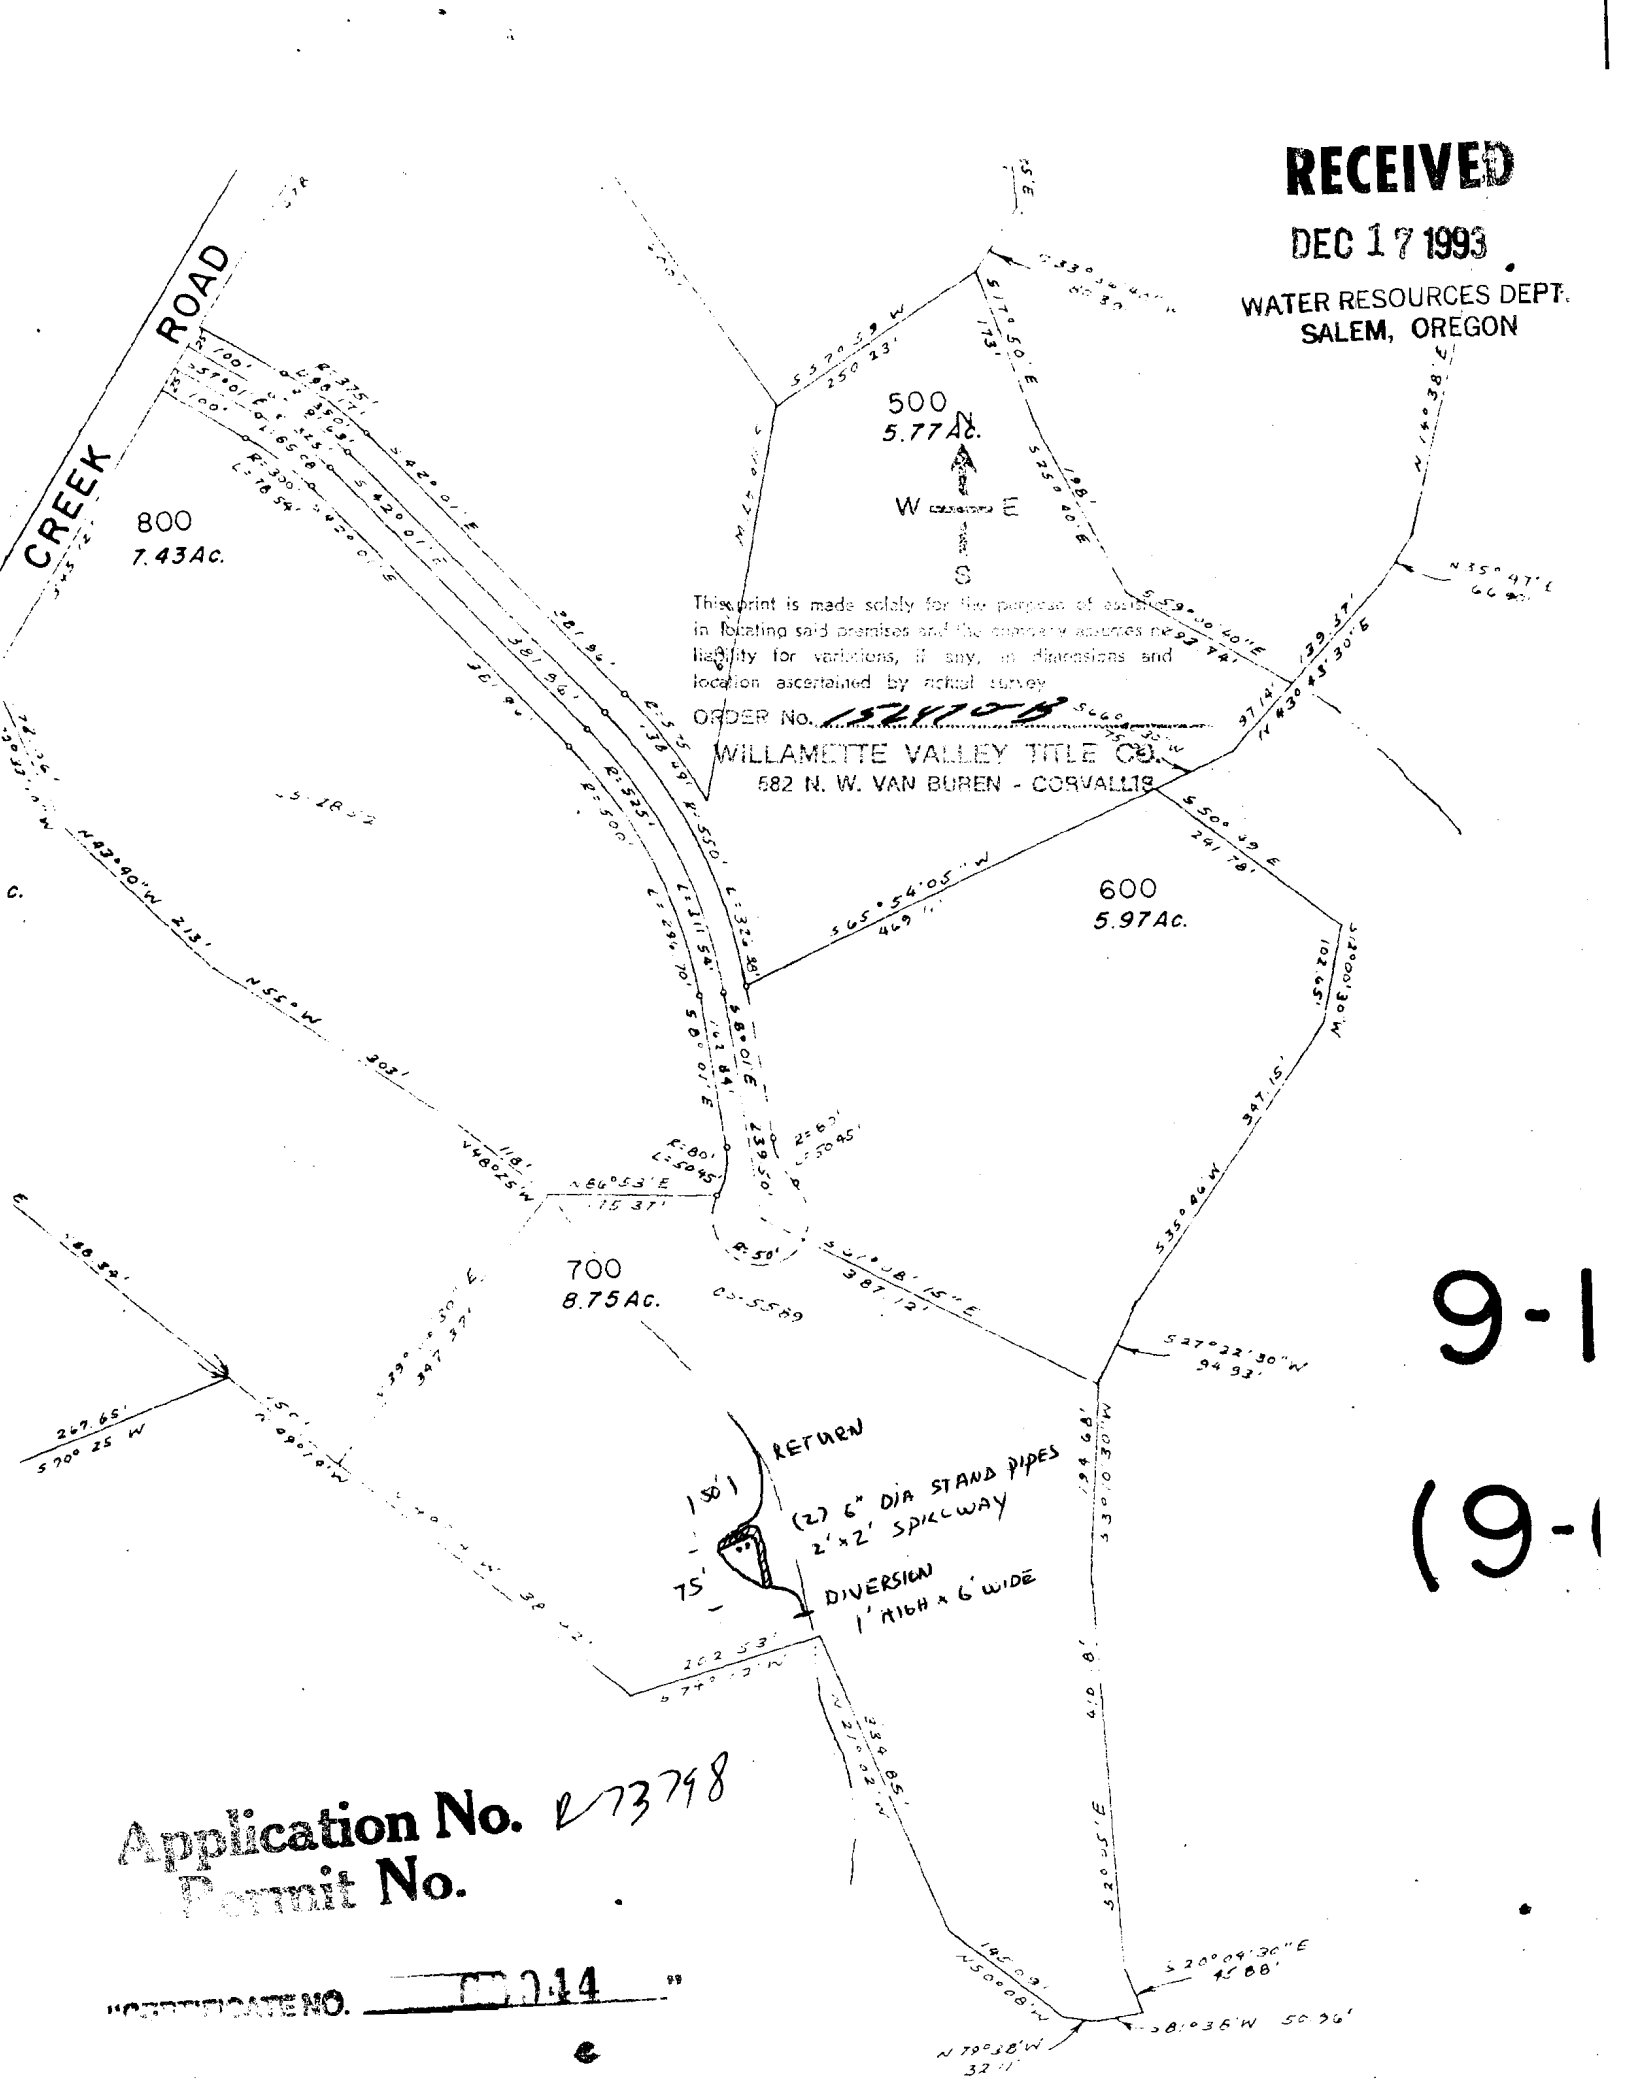

RECEIVED
DEC 17 1993
WATER RESOURCES DEPT.
SALEM, OREGON

9-1

(9-1

Application No. R73798
Permit No.

"CERTIFICATE NO. [illegible]14"

SEE MAP 10 5 35