0103126

Application No. 73814
Permit No.

"CERTIFICATE NO. 34"

RECEIVED
DEC 23 1993
WATER RESOURCES DEPT.
SALEM, OREGON
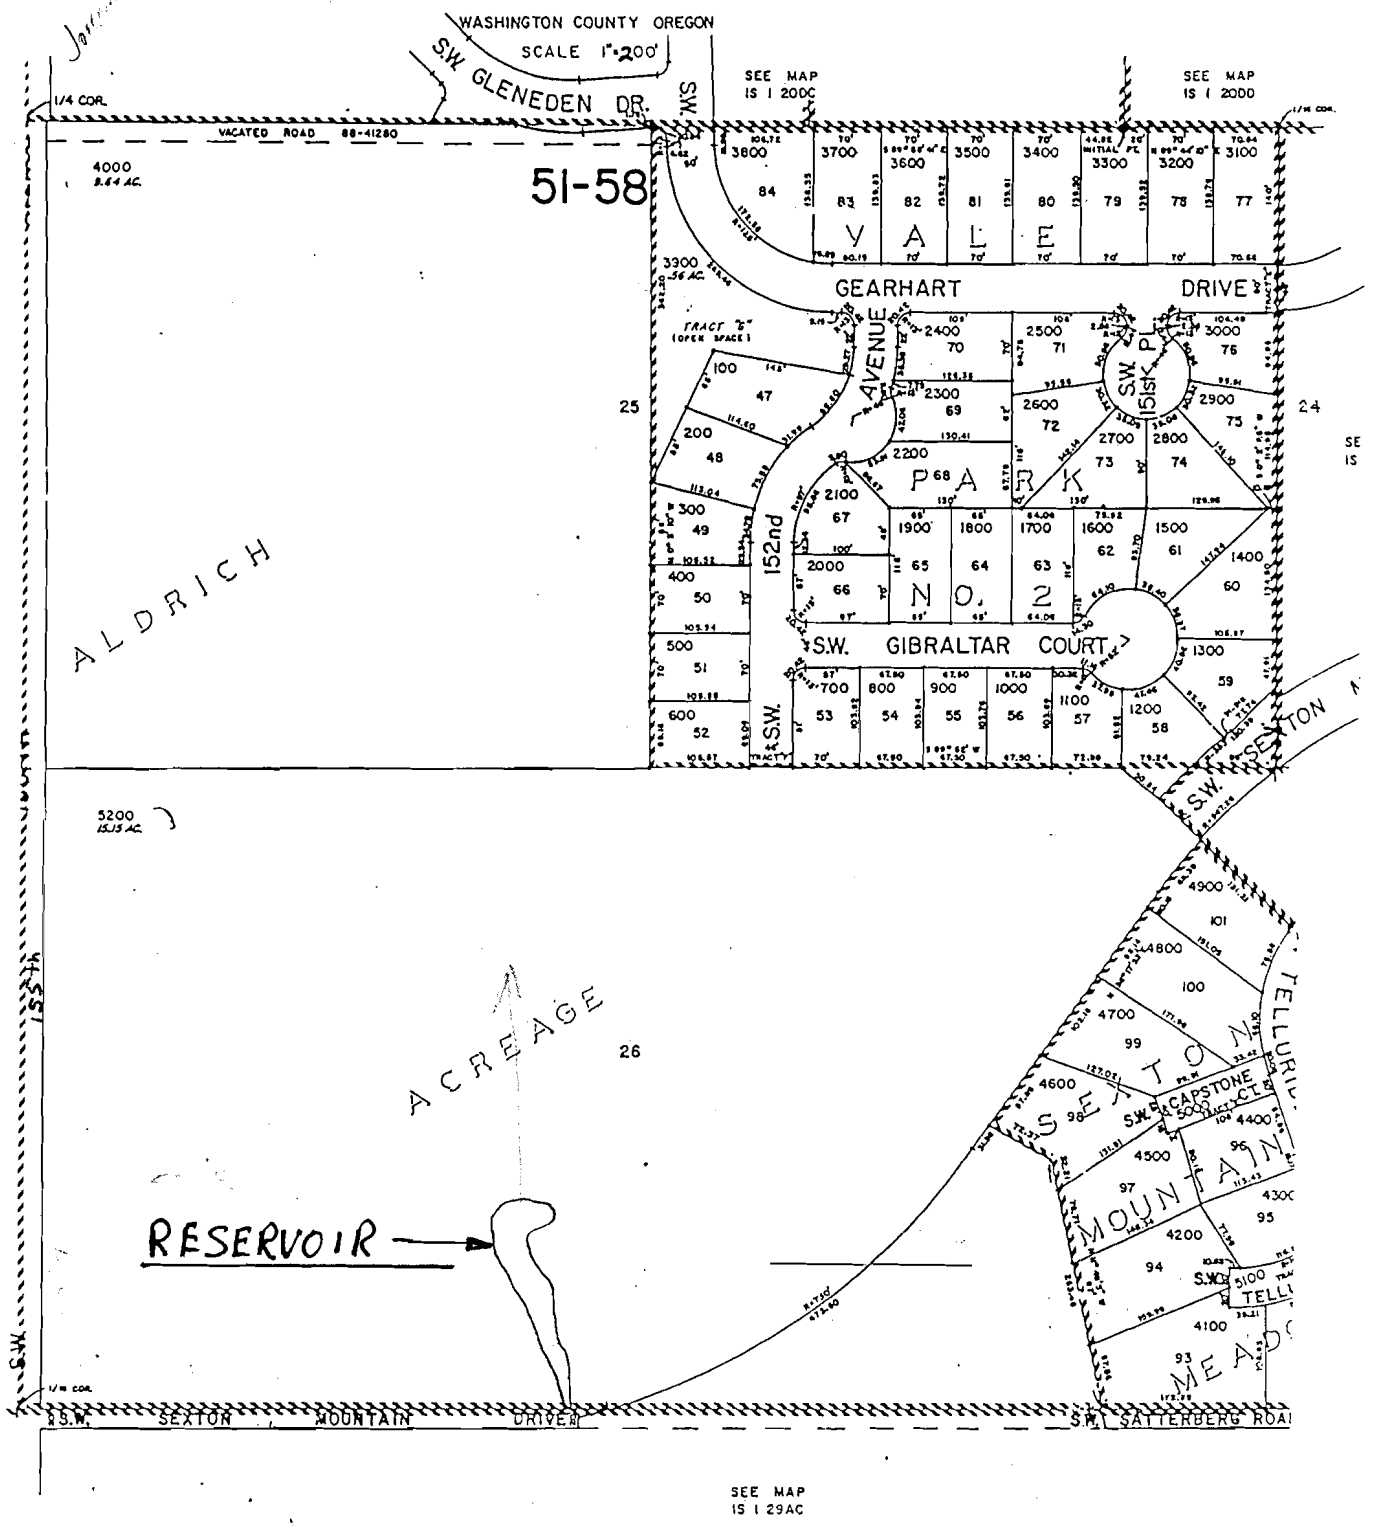
NW1/4 NE1/4 SECTION 29 T1S R1W W.M.