



T. 29 S., R. 1 W., W.M.

SCALE: 1" = 400'

POINT OF DIVERSION #1 IS 892 FEET NORTH
AND 446 FEET WEST OF THE CENTER 1/4
CORNER TO SECTION 33, TOWNSHIP 29 SOUTH,
RANGE 1 WEST, W. M.

POINT OF DIVERSION #1 → SPRING → RES. 0.35 AC.-FT. → STOCKWATER

POINT OF DIVERSION #2 IS 857 FEET NORTH
AND 544 FEET EAST OF THE CENTER 1/4
CORNER TO SECTION 33, TOWNSHIP 29 SOUTH,
RANGE 1 WEST, W. M.


POINT OF DIVERSION #2 → SPRING → STORAGE TANK

SEC. 33

THE PURPOSE OF THIS MAP IS TO
IDENTIFY THE LOCATION OF THE WATER
RIGHT. IT IS NOT INTENDED TO PROVIDE
INFORMATION RELATIVE TO THE LOCATION
OF PROPERTY OWNERSHIP BOUNDARY
LINES.



EXP. 12/31/2001

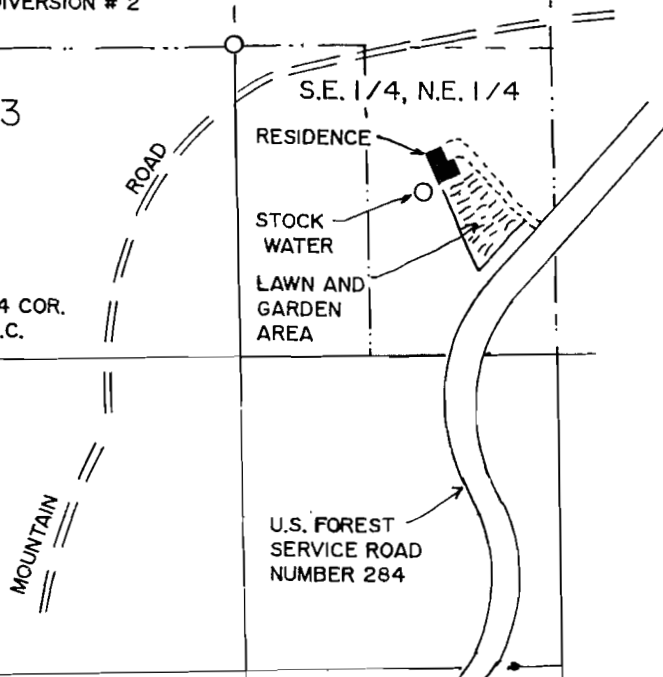

FINAL PROOF SURVEY

UNDER

Application No. S- 73852
R- 73851

Permit No. 52800

IN NAME OF

LEVI V. AND AGNES F. CAMPBELL

Surveyed: SEPT. 18, 2000

by: R.F. BROWN