


SECTION 34 T14S R11W WM
LINCOLN COUNTY
1" = 400'

COPY

See Map 14 11

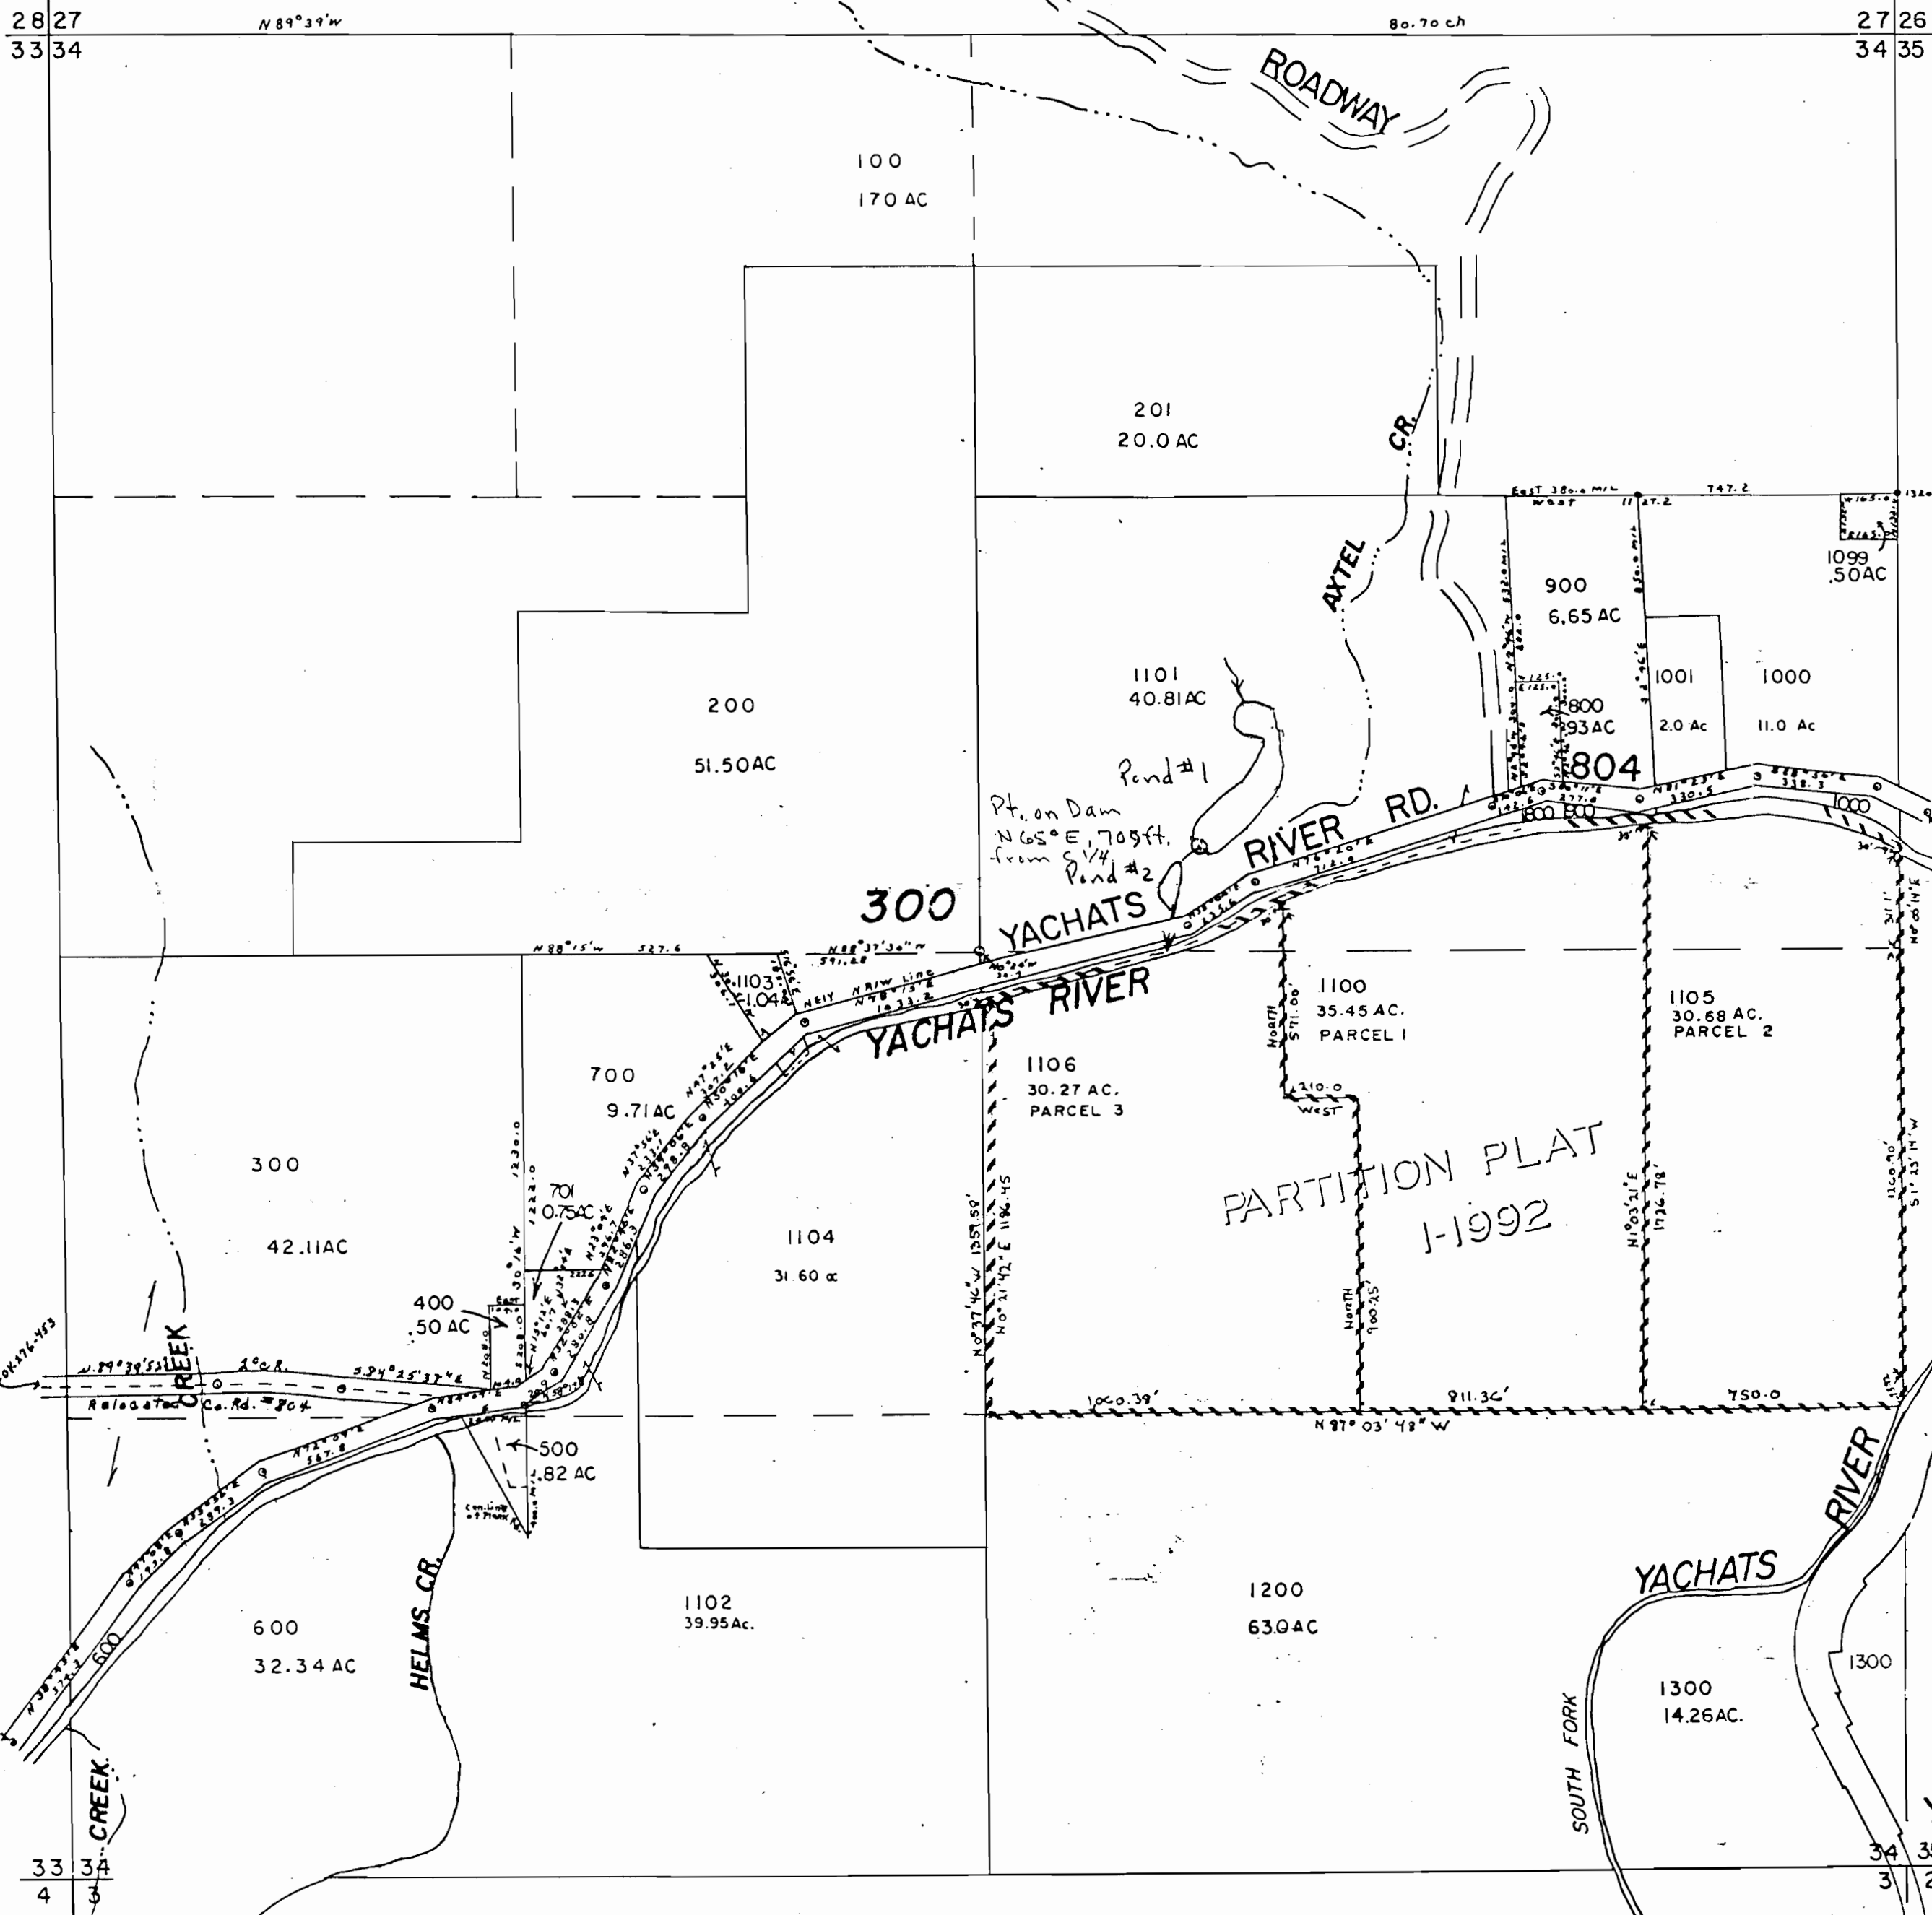

CANCELLED NO.
1200-TI

See Map 14 11



Application No. R-73862
Permit No.
"CERTIFICATE NO. 69061"

YACHATS RIVER RD. 804

See Map 15 11