


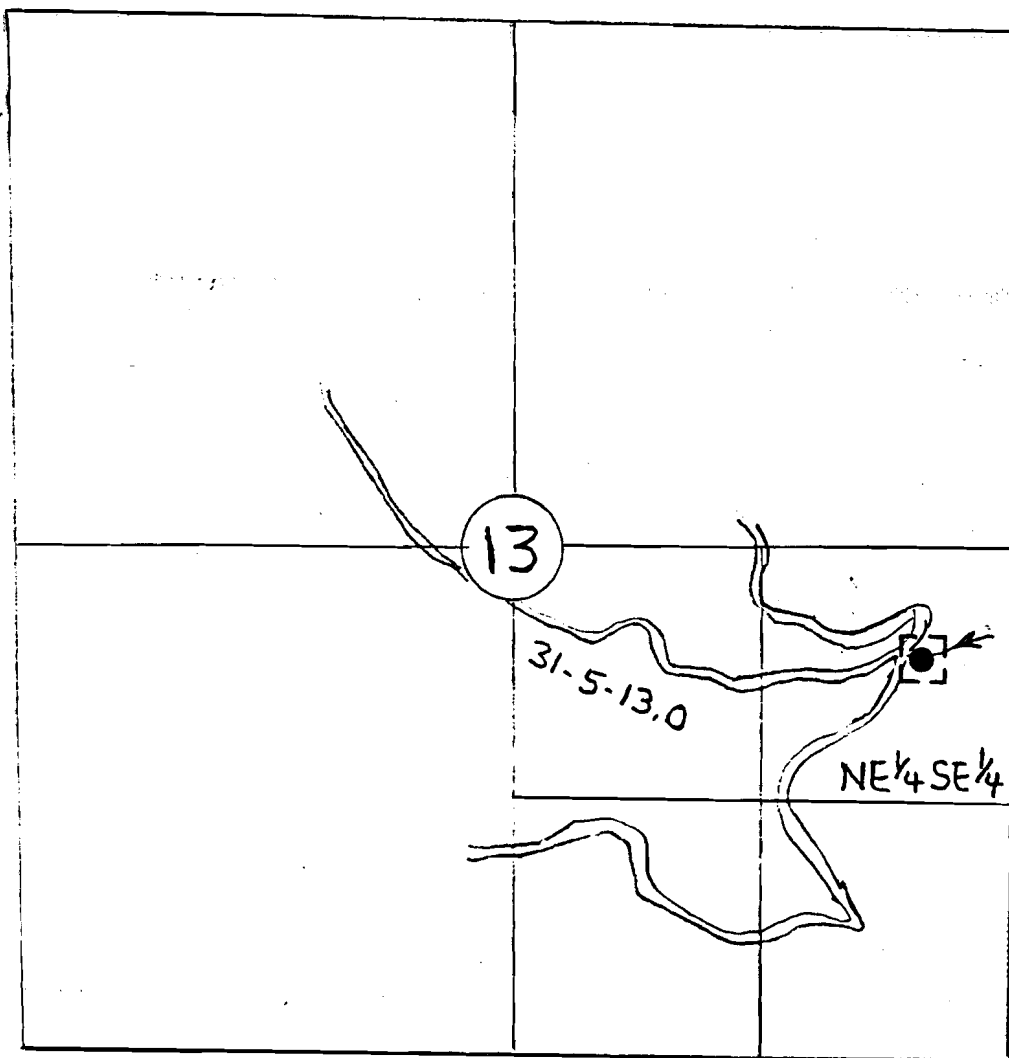

Scale 1" = 1000'

TURKEY CREEK PUMP CHANCE
T31S R5W Sec 13
NE $\frac{1}{4}$ SE $\frac{1}{4}$

The point of diversion is located approximately 550 ft South and 530 ft West from the East Section Quarter Corner of Section 13.

Coordinate Ties are based on aerial photo 13-18-12.

The map is shown for the purpose of water application and not property boundary.

Application No. R-73865
Permit No.

"CERTIFICATE NO. 69063"

