


FINAL PROOF MAP

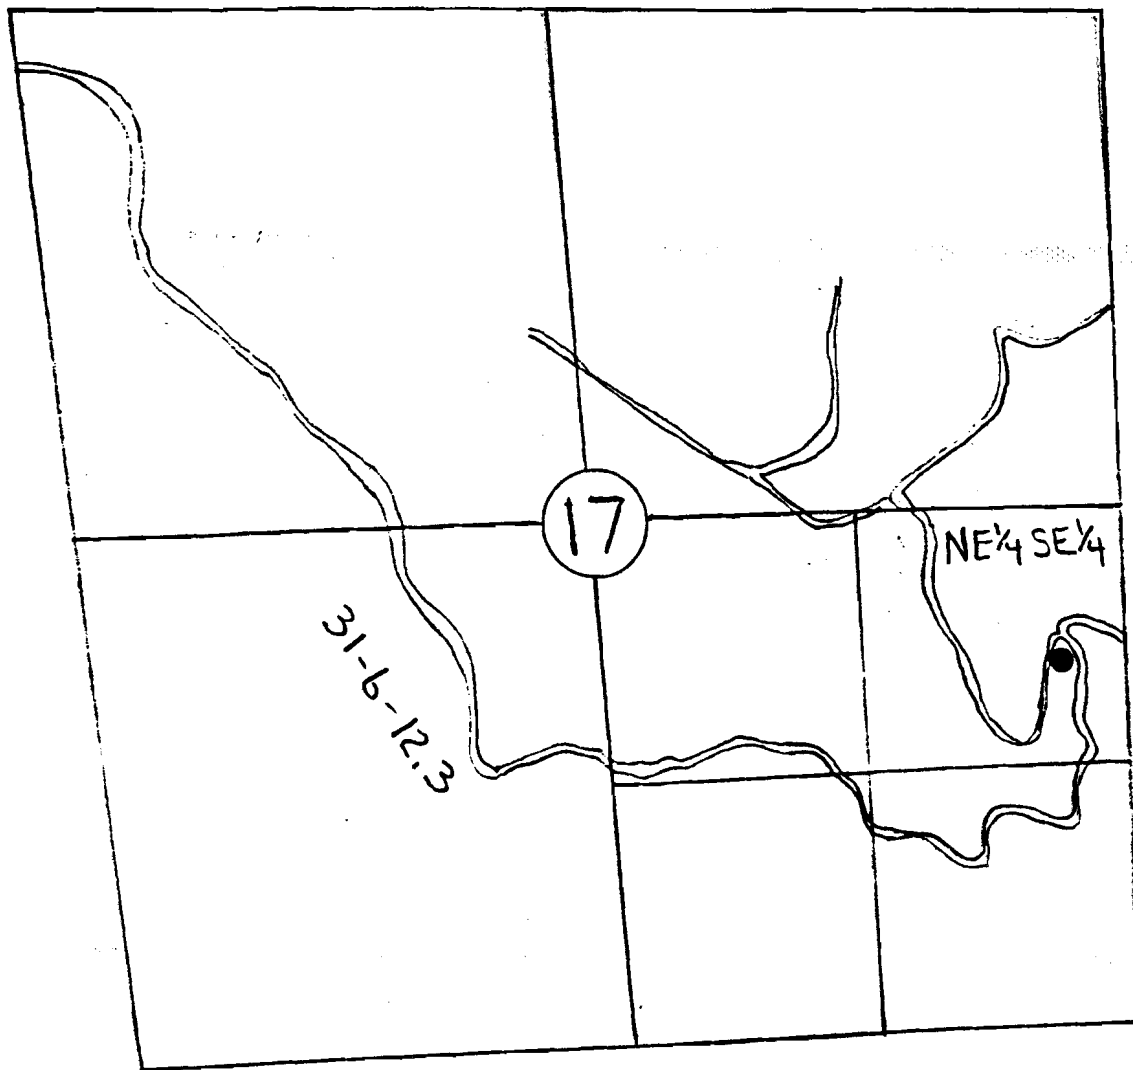

Scale 1" = 1000'

MAGIC MOUNTAIN PUMP CHANCE
T31S R5W Sec 17
NE 1/4 SE 1/4

The point of diversion is located approximately 840 ft South and 320 ft West from the East Section Quarter Corner of Section 17.


Coordinate Ties are based on aerial photo 15-24-10.

The map is shown for the purpose of water application and not property boundary.

Application No. R-73869

Permit No.

"CERTIFICATE NO. 69065"

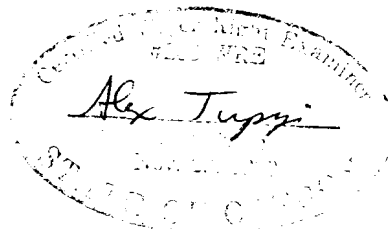

11-26-93