


FINAL PROOF MAP

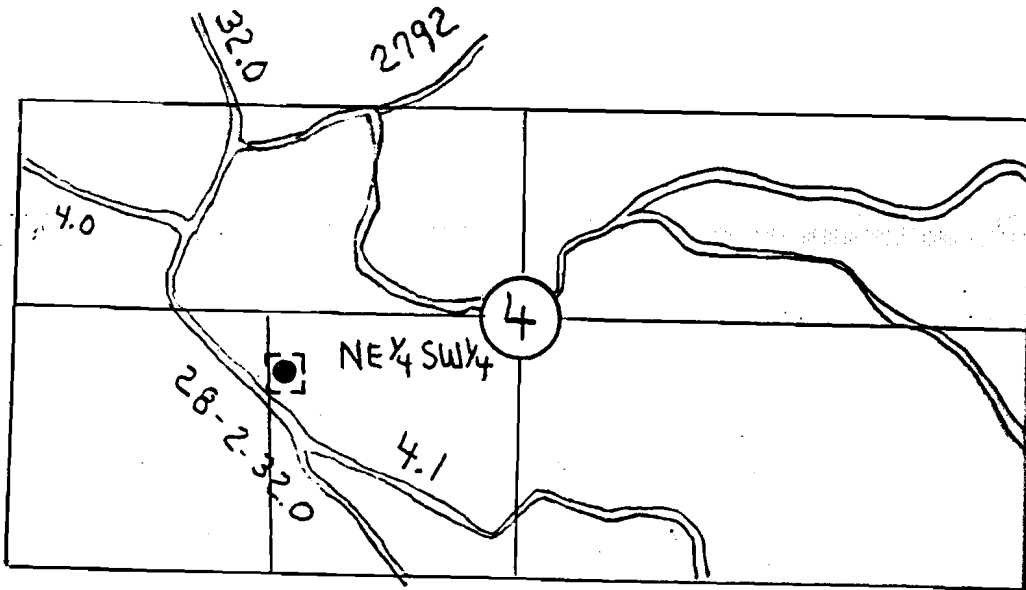

Scale 1" = 1000

RED TOP HELIPOND
 T29S R2W Sec 4
 NE 1/4 SW 1/4

The point of diversion is located approximately 1050 ft North and 1400 ft East from the Southwest Section Corner of Section 4.


Coordinate Ties are based on aerial photo 8-43-21.

The map is shown for the purpose of water application and not property boundary.

"CERTIFICATE NO. 69068"

Application No. 12-73875
 Permit No.

0105742762

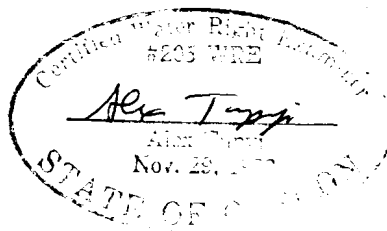

11-26-93