


T 31 S, R 37 E, WM

RECEIVED

JAN 28 1994

WATER RESOURCES DEPT.
SALEM, OREGON

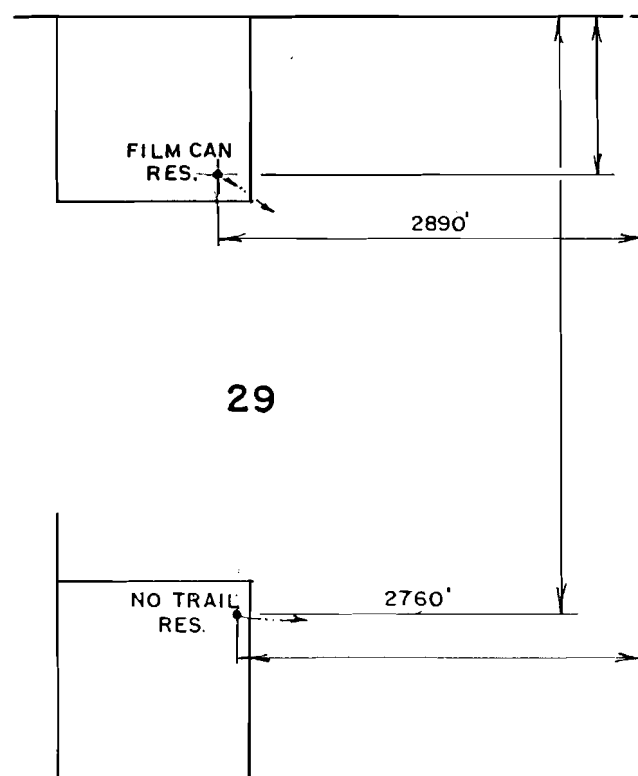


Application No. R-73894
Permit No.

THE PURPOSE OF THIS MAP IS TO
IDENTIFY THE LOCATION OF THE
WATER RIGHT. IT IS NOT INTENDED
TO PROVIDE INFORMATION RELATIVE
TO THE LOCATION OF PROPERTY
OWNERSHIP.

"CERTIFICATE NO. 00074"

B.L.M.

WATER RIGHT APPLICATION
MAP

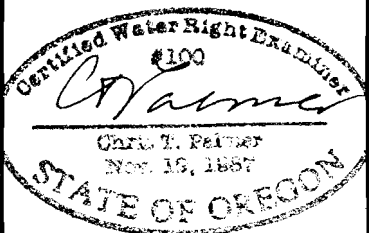

Scale: 4" = 1 MILE

Date: NOV 1993

Job: 1287-93

Dsn:

Drn: CTP

Ckd:

MAP's

M. A. PALMER & SONS, INC.
ENGINEERING & SURVEYING
254 N. Alder - Box 61
Burns, Oregon 97720

Sht. No.

of 1