T 31 S, R 36 E, WM

RECEIVED
JAN 28 1994
WATER RESOURCES DEPT.
SALEM, OREGON

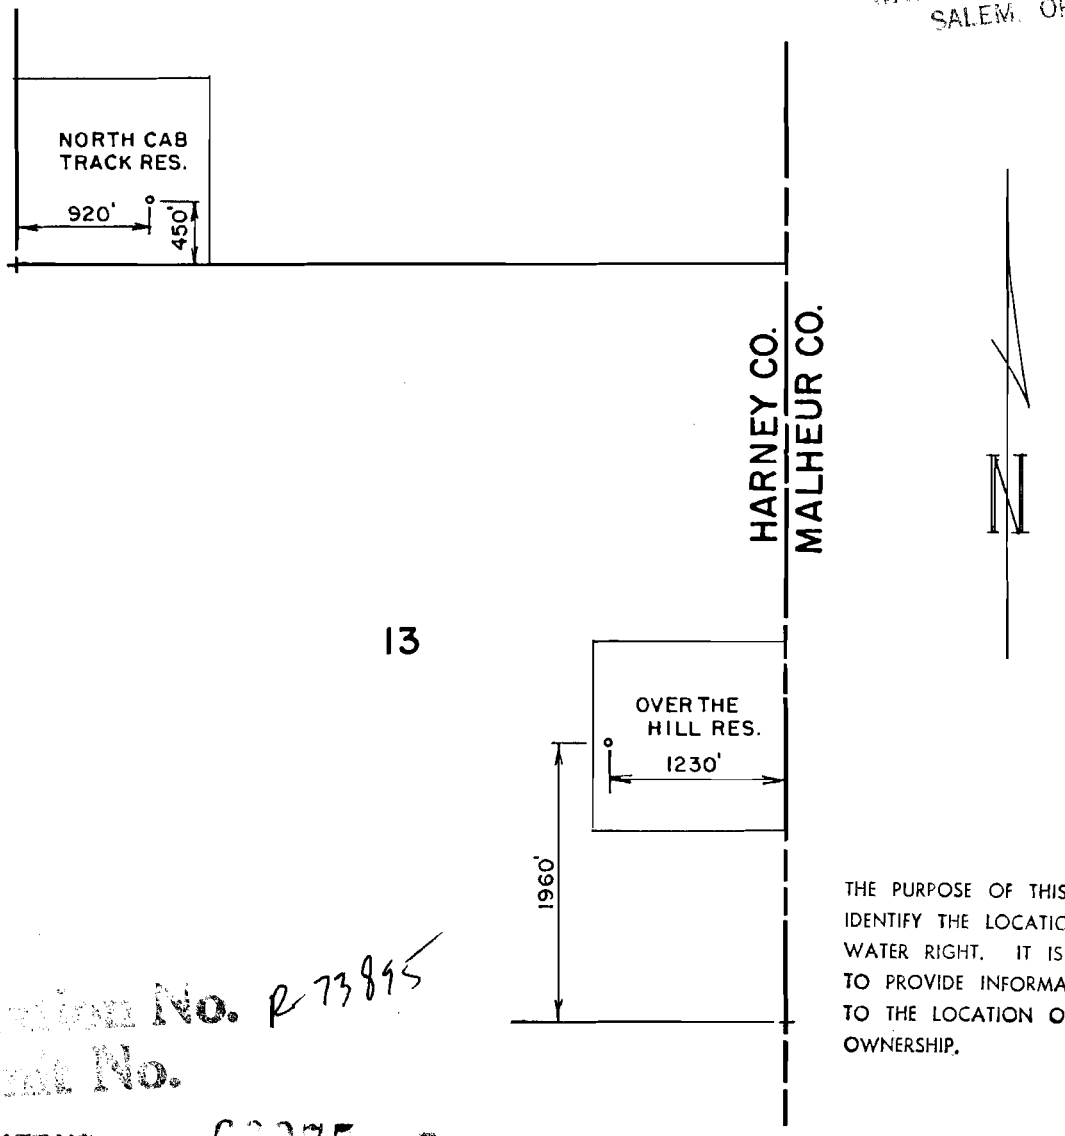

THE PURPOSE OF THIS MAP IS TO IDENTIFY THE LOCATION OF THE WATER RIGHT. IT IS NOT INTENDED TO PROVIDE INFORMATION RELATIVE TO THE LOCATION OF PROPERTY OWNERSHIP.

Application No. R 73895
Permit No.
"CERTIFICATE NO. [illegible]"

Certified Water Right Examiner #100
Carl T. Palmer
Nov. 19, 1987
STATE OF OREGON

B.L.M.

WATER RIGHT APPLICATION MAP

Scale: 4" = 1 MILE	Date: NOV 1993	Job: 1287-93
Dsn:	M. A. PALMER & SONS, INC.	Sht. No.
Drn: CTP	MAP's ENGINEERING & SURVEYING	of 1
Ckd:	254 N. Alder - Box 61 Burns, Oregon 97720	