


T 31 S, R 36 E, WM

12

RECEIVED

JAN 28 1994

WATER RESOURCES DEPT.
SALEM, OREGON

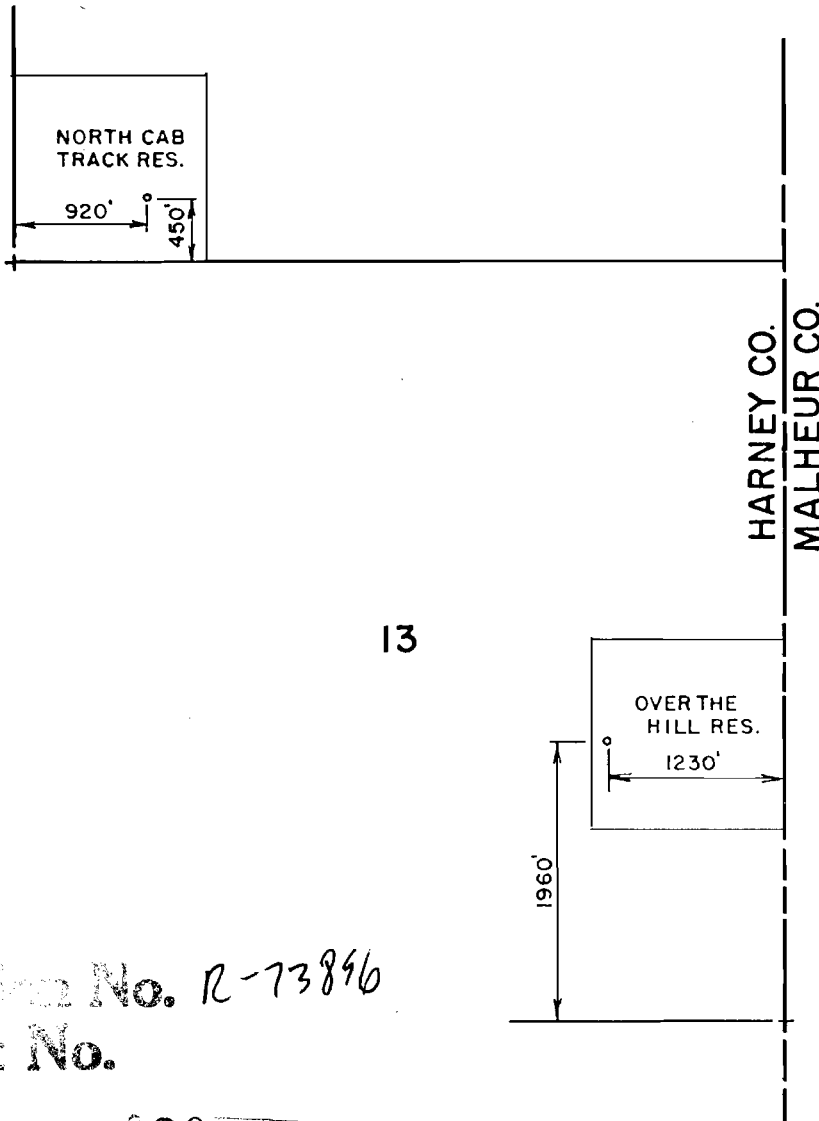


THE PURPOSE OF THIS MAP IS TO
IDENTIFY THE LOCATION OF THE
WATER RIGHT. IT IS NOT INTENDED
TO PROVIDE INFORMATION RELATIVE
TO THE LOCATION OF PROPERTY
OWNERSHIP.

Permit No. R-73896
Permit No.

CERTIFICATE NO. 09076

B.L.M.

WATER RIGHT APPLICATION MAP

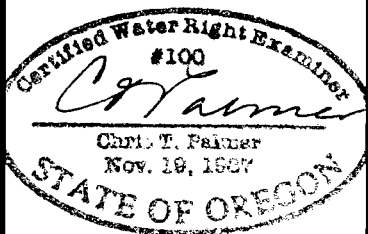

Scale: 4" = 1 MILE

Date: NOV 1993

Job: 1287-93

Dsn:

Drn: CTP

Ckd:



M. A. PALMER & SONS, INC.
ENGINEERING & SURVEYING
254 N. Alder - Box 61
Burns, Oregon 97720

Sht. No.

of 1