


T 31 S, R 36 E, WM

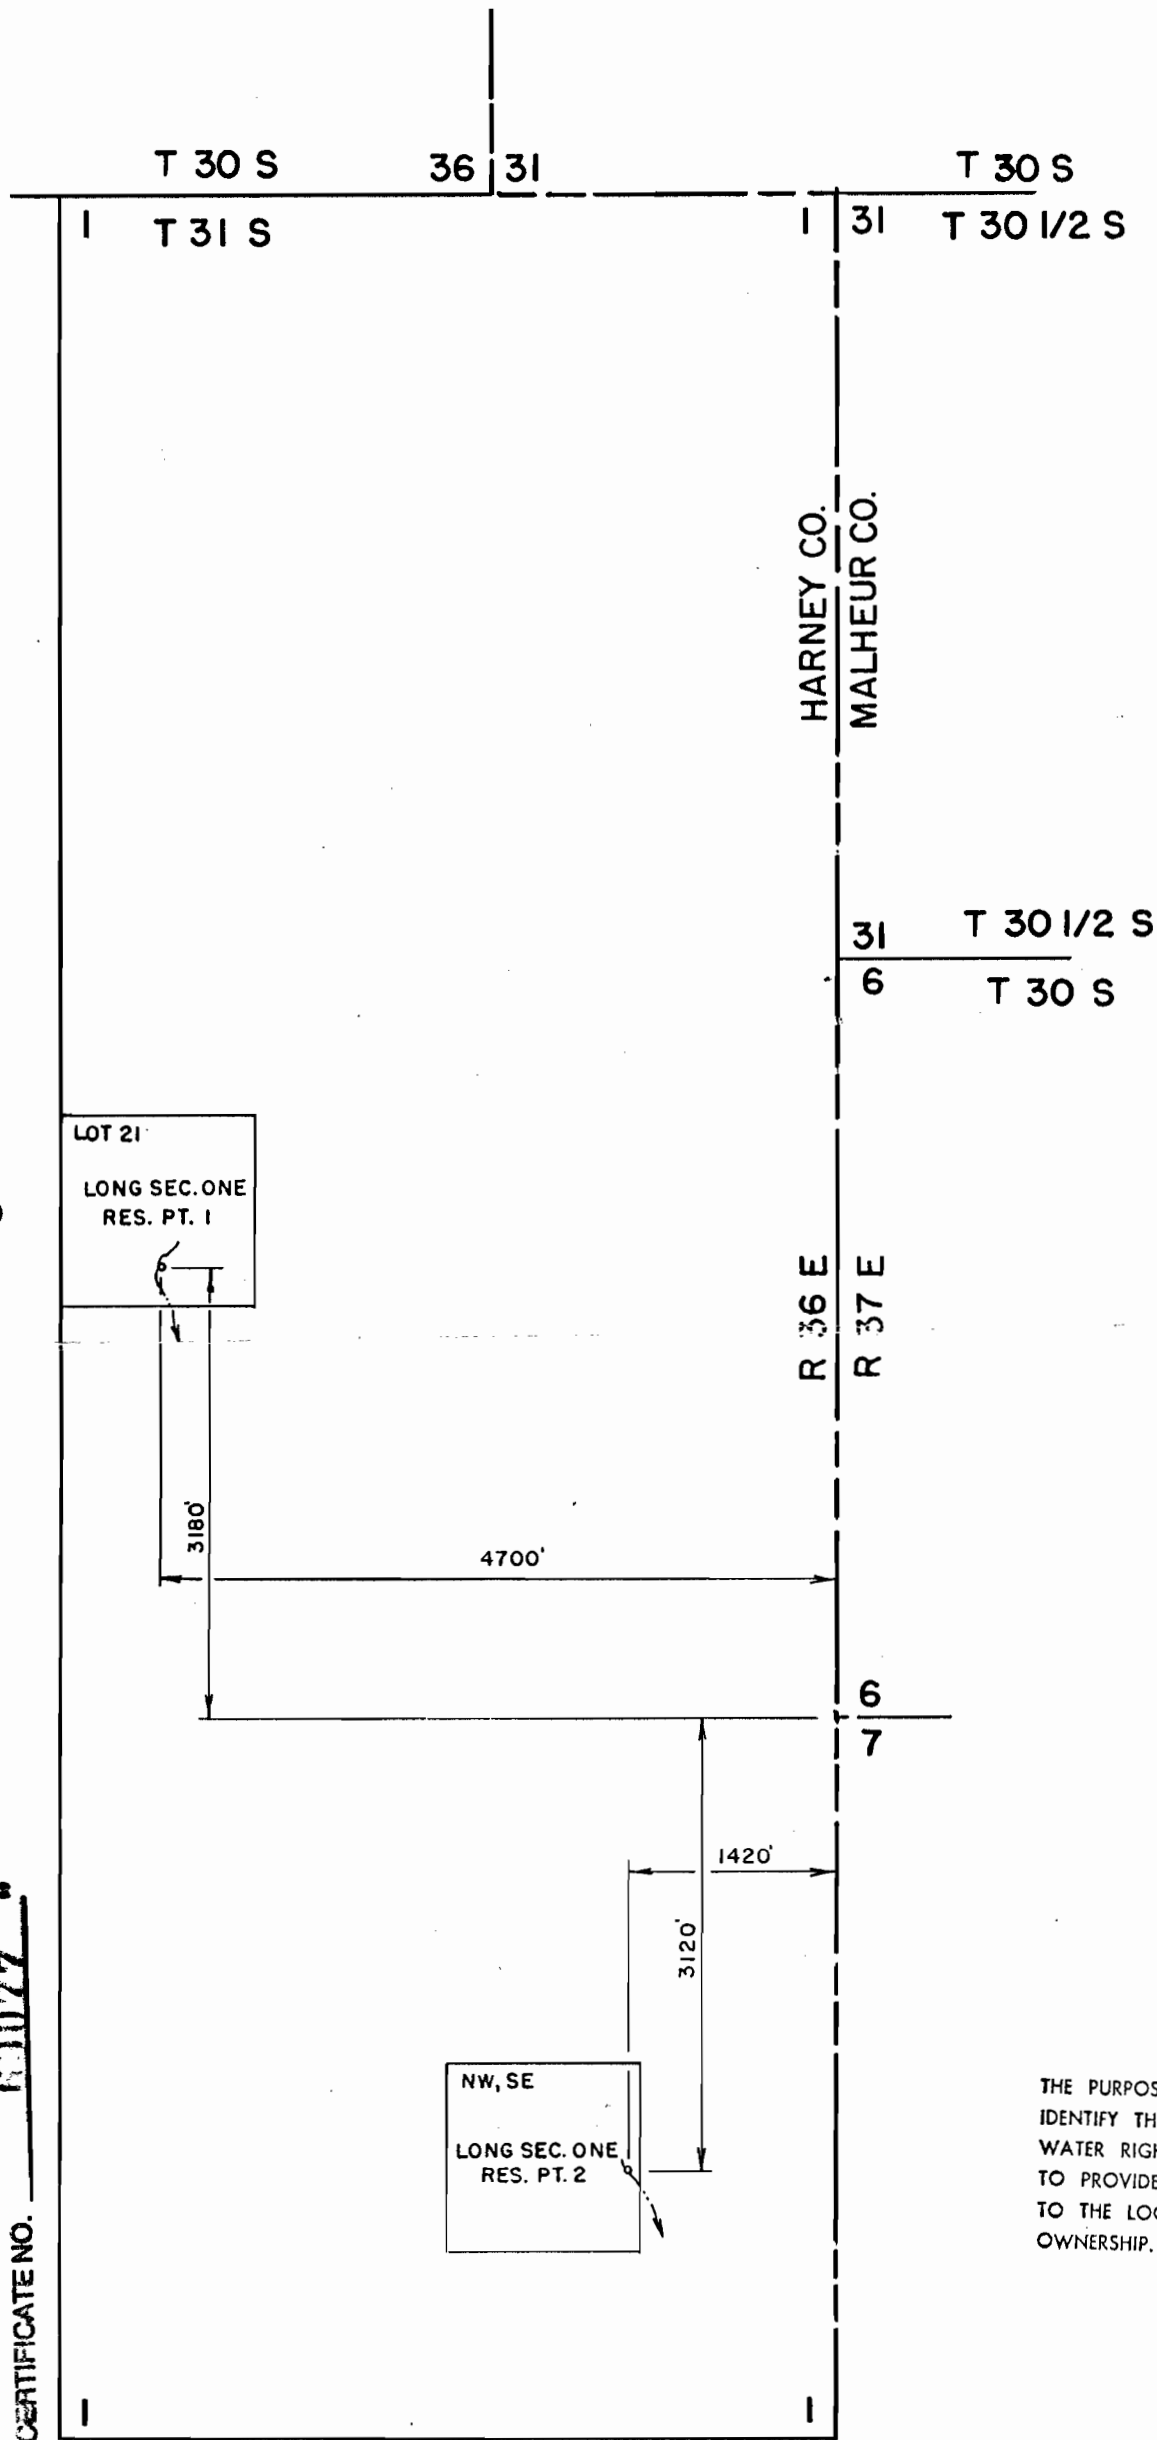

THE PURPOSE OF THIS MAP IS TO IDENTIFY THE LOCATION OF THE WATER RIGHT. IT IS NOT INTENDED TO PROVIDE INFORMATION RELATIVE TO THE LOCATION OF PROPERTY OWNERSHIP.

RECEIVED

JAN 28 1994

WATER RESOURCES DEPT.
SALEM, OREGON

Application No. R-73897
Permit No.

CERTIFICATE NO. 63077

	B.L.M.		
	WATER RIGHT APPLICATION MAP		
	Scale: 4" = 1 MILE	Date: NOV 1993	Job: 1287-93
	Dsn:	 M. A. PALMER & SONS, INC. ENGINEERING & SURVEYING 254 N. Alder - Box 61 Burns, Oregon 97720	Sht. No.
Drn: CTP	of 1		
Ckd:			