


T 31 S, R 36 E, WM

RECEIVED

14N 28 1994
WATER RESOURCES DEPT.
SALEM, OREGON

Application No. 2-73898
- Permit No.

"CERTIFICATE NO. 63078"

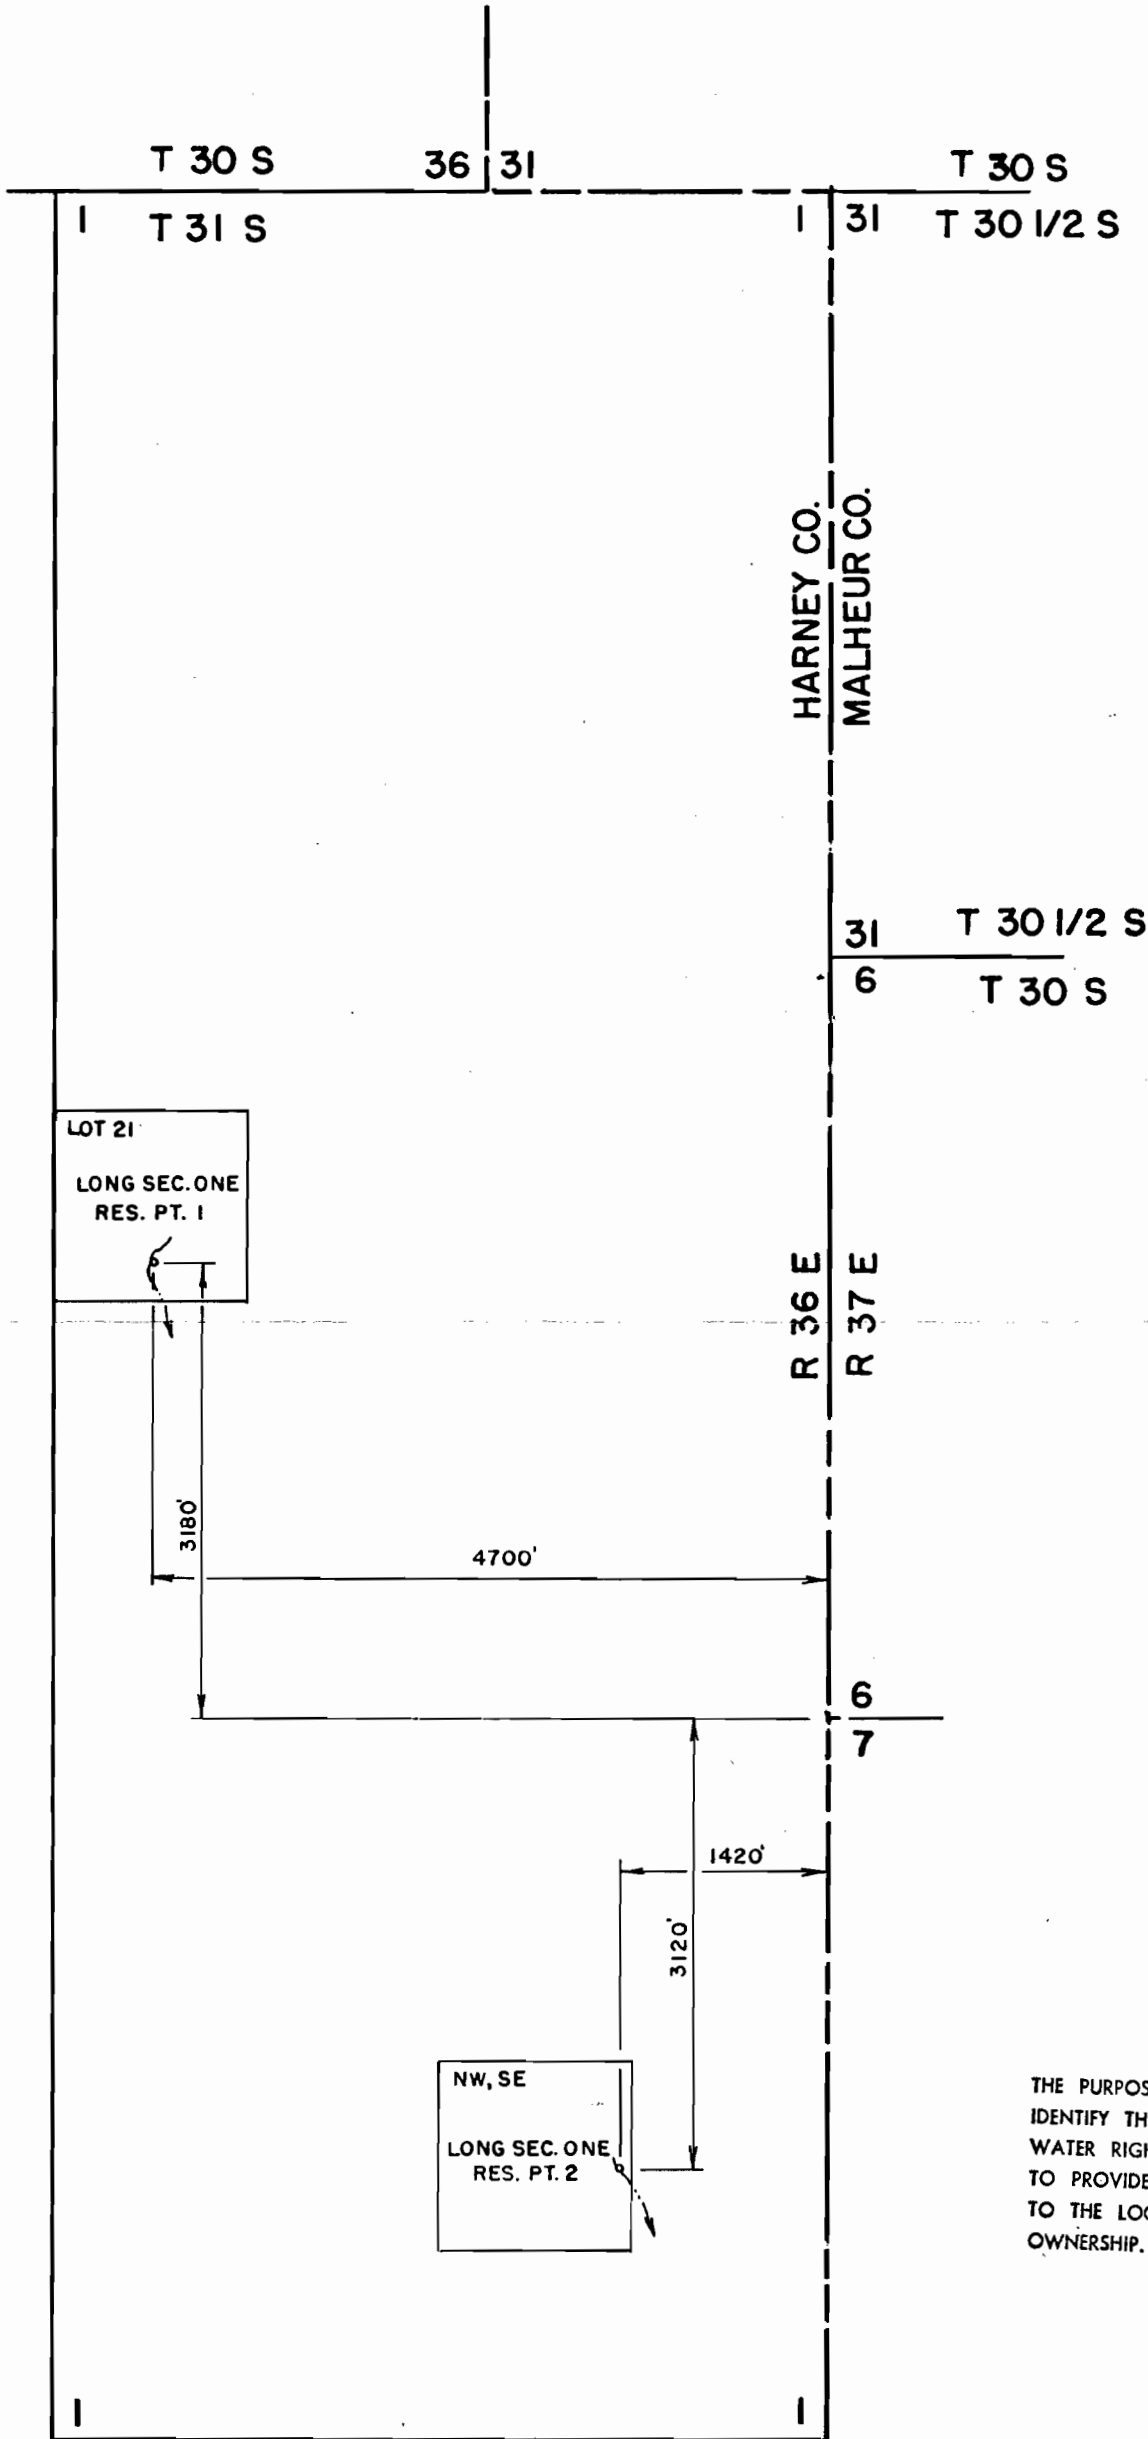

THE PURPOSE OF THIS MAP IS TO IDENTIFY THE LOCATION OF THE WATER RIGHT. IT IS NOT INTENDED TO PROVIDE INFORMATION RELATIVE TO THE LOCATION OF PROPERTY OWNERSHIP.

	B.L.M.		
	WATER RIGHT APPLICATION MAP		
	Scale: 4" = 1 MILE	Date: NOV 1993	Job: 1287-93
	Dsn:	M.A.P's M. A. PALMER & SONS, INC. ENGINEERING & SURVEYING 254 N. Alder - Box 61 Burns, Oregon 97720	Sht. No.
Drn: CTP	of 1		
Ckd:			