


T 30 S, R 36 E, WM

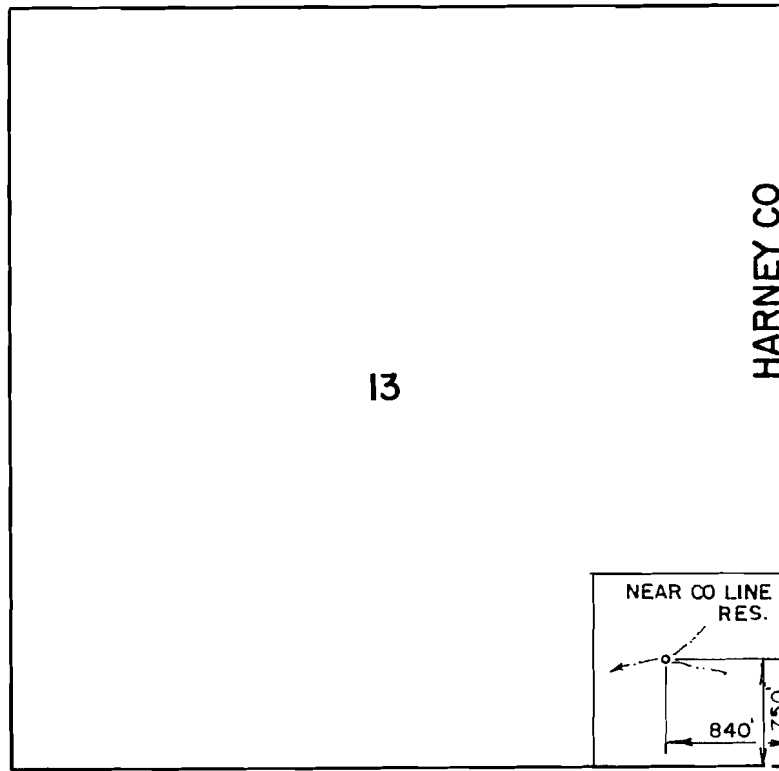

HARNEY CO
MALHEUR CO



RECEIVED

JAN 28 1994

WATER RESOURCES DEPT
SALEM, OREGON


Application No. R-73903
Figure No.

THE PURPOSE OF THIS MAP IS TO
IDENTIFY THE LOCATION OF THE
WATER RIGHT. IT IS NOT INTENDED
TO PROVIDE INFORMATION RELATIVE
TO THE LOCATION OF PROPERTY
OWNERSHIP.

CERTIFICATE NO. 69033

B.L.M.

WATER RIGHT APPLICATION MAP

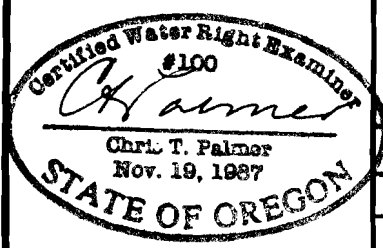

Scale: 4" = 1 MILE	Date: NOV 1993	Job: 1287-93
Dsn:	 M. A. PALMER & SONS, INC. ENGINEERING & SURVEYING 254 N. Alder - Box 61 Burns, Oregon 97720	Sht. No.
Drn: CTP		of 1
Ckd:		