


T 32 S, R 35 E, WM

RECEIVED

JAN 28 1994

WATER RESOURCES DEPT
SALEM, OREGON

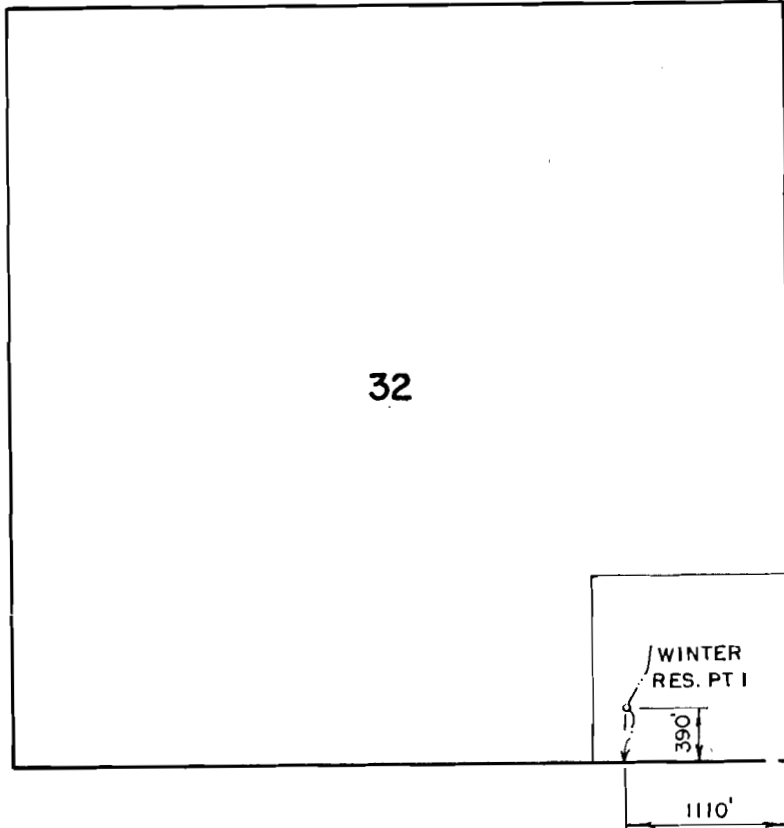

N

THE PURPOSE OF THIS MAP IS TO
IDENTIFY THE LOCATION OF THE
WATER RIGHT. IT IS NOT INTENDED
TO PROVIDE INFORMATION RELATIVE
TO THE LOCATION OF PROPERTY
OWNERSHIP.

Permit No. R-73908
Permit No.

"CERTIFICATE NO.

00087

B.L.M.

WATER RIGHT APPLICATION MAP



Scale: 4" = 1 MILE

Date: NOV 1993

Job: 1287-93

Dsn:

Drm: CTP

Ckd:

MAP's

M. A. PALMER & SONS, INC.
ENGINEERING & SURVEYING
254 N. Alder - Box 61
Burns, Oregon 97720

Sht. No.

of 1