


Application No. R-73912
Permit No.

CERTIFICATE NO. 63091

T 39 S, R 37 E, W.M.

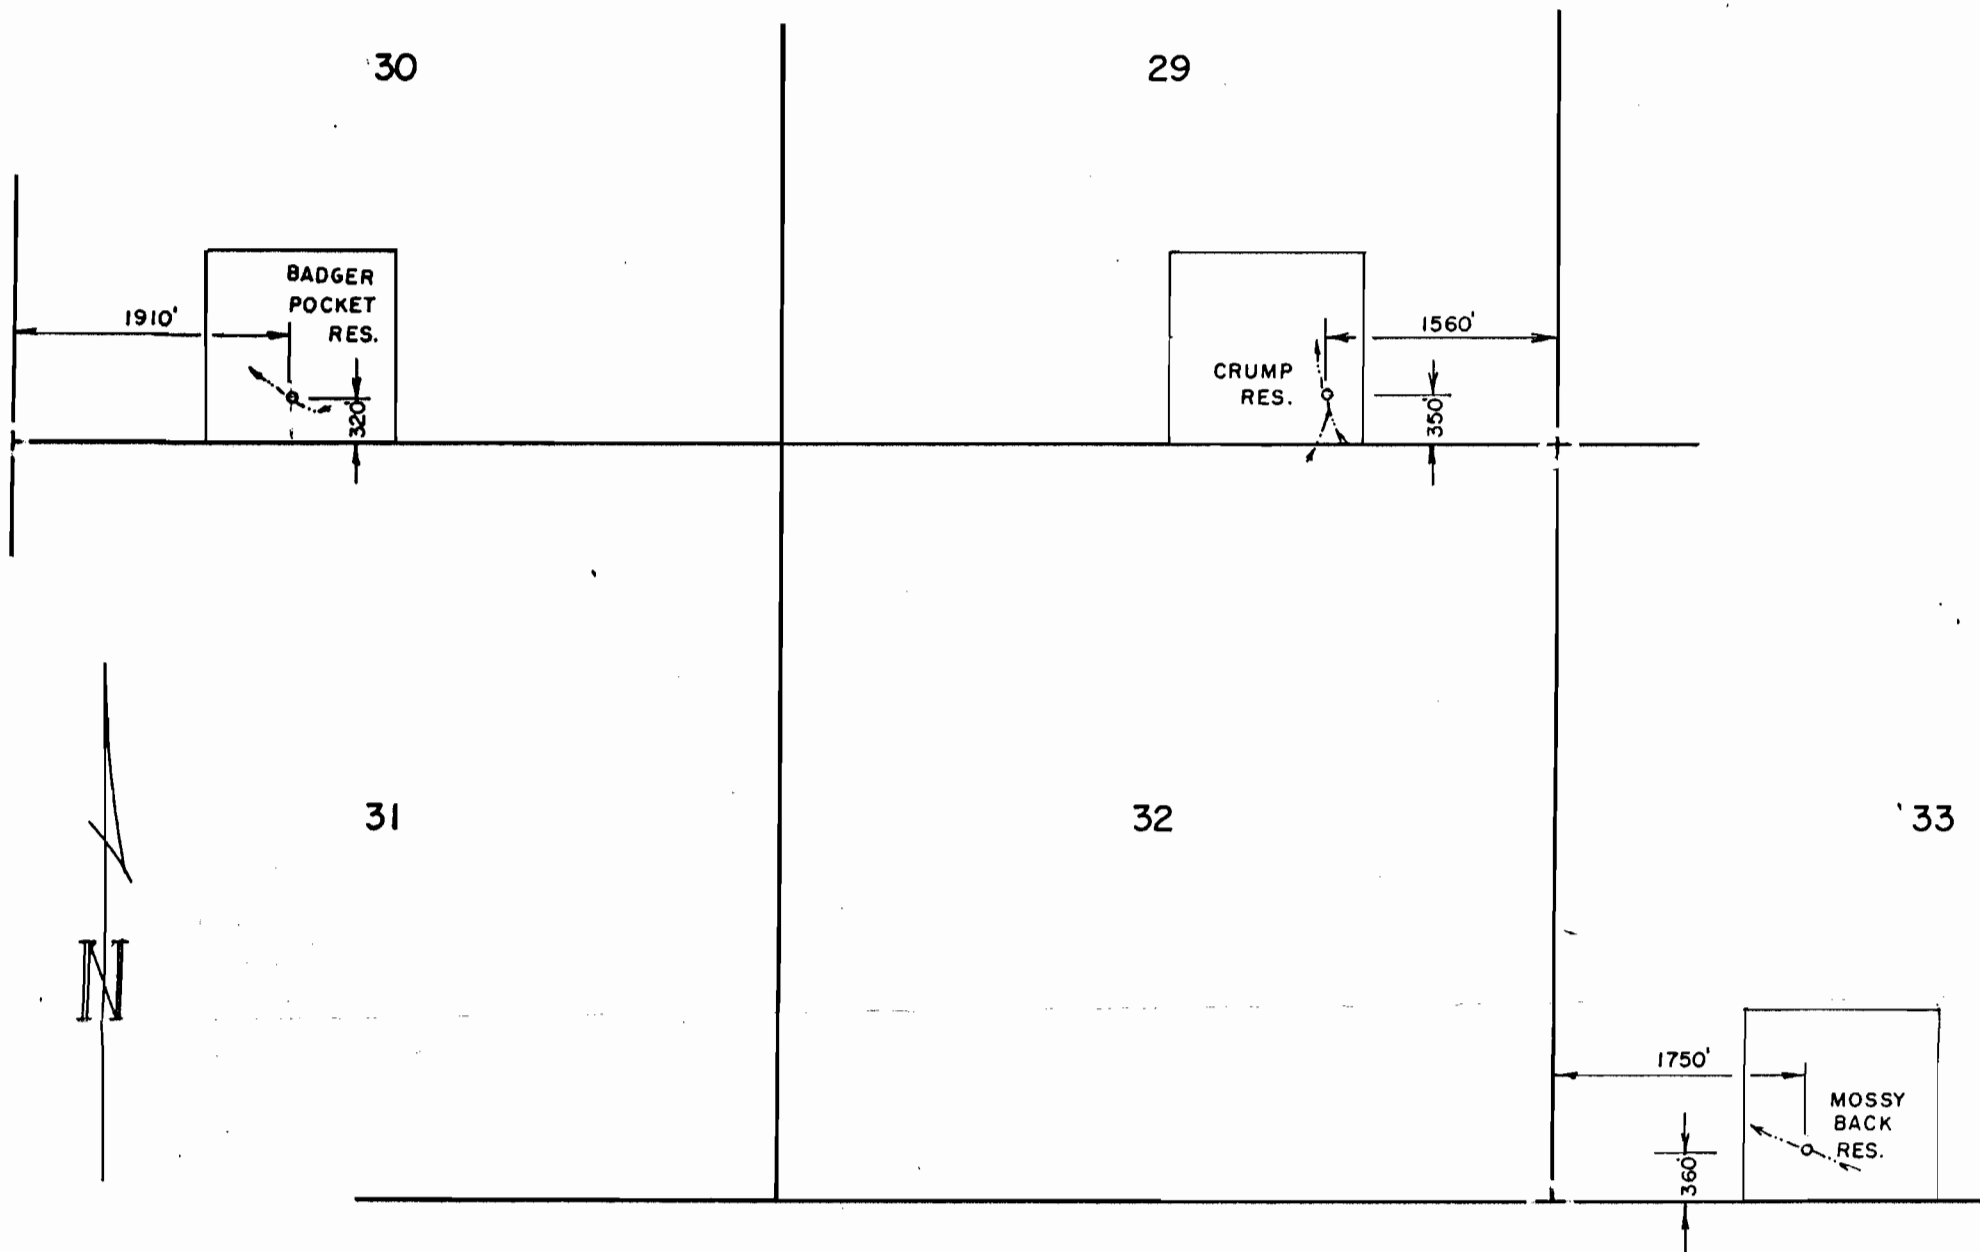


THE PURPOSE OF THIS MAP IS TO
IDENTIFY THE LOCATION OF THE
WATER RIGHT. IT IS NOT INTENDED
TO PROVIDE INFORMATION RELATIVE
TO THE LOCATION OF PROPERTY
OWNERSHIP.

RECEIVED

JAN 28 1994

WATER RESOURCES DEPT.
SALEM, OREGON

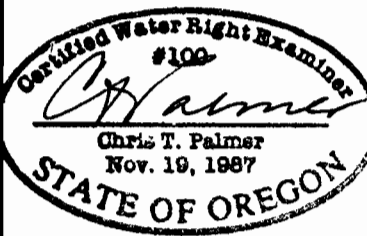	B.L.M.		
	WATER RIGHT APPLICATION MAP		
	Scale: 4" = 1 MILE	Date: NOV 1993	Job: 1287-93
	Dsn:	 M. A. PALMER & SONS, INC. ENGINEERING & SURVEYING 254 N. Alder - Box 61 Burns, Oregon 97720	Sht. No.
Drn: CTP	of 1		
Ckd:			