


Application No. R-73915
Permit No.


T 36 S,
T 37 S, R. 32 1/2 E, W.M.

"CERTIFICATE NO. 63094"

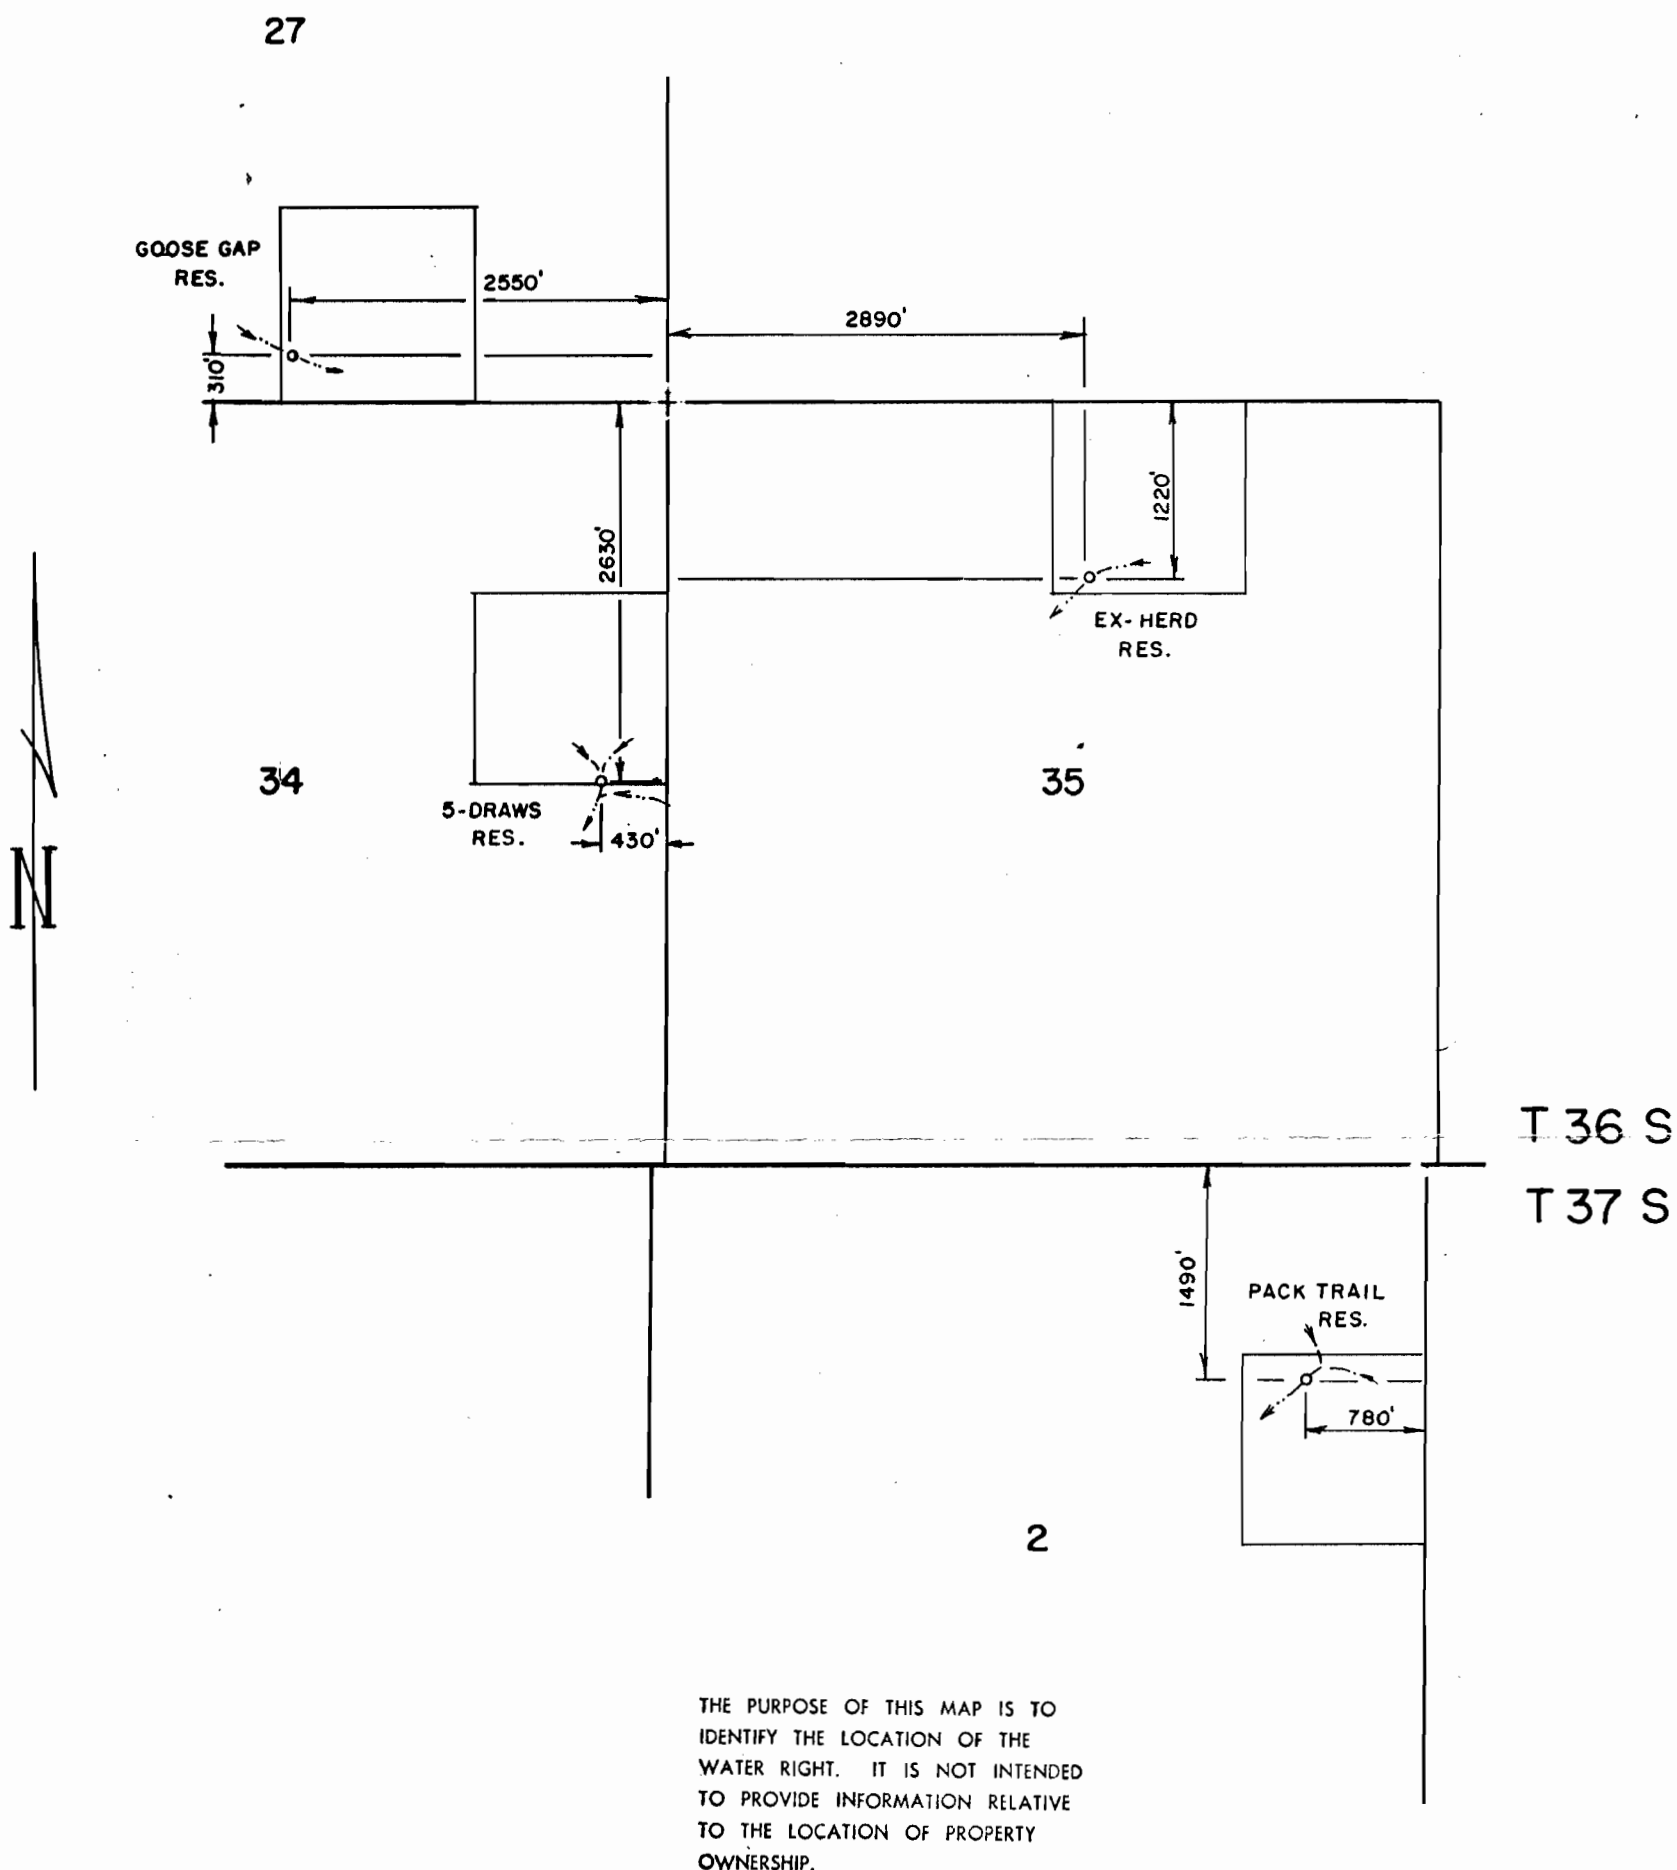

RECEIVED

JAN 28 1994
WATER RESOURCES DEPT.
SALEM, OREGON

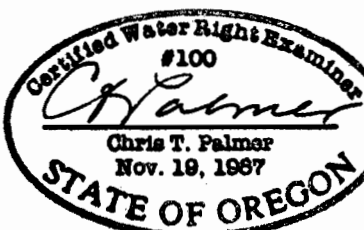	B.L.M.		
	<u>WATER RIGHT APPLICATION</u> <u>MAP</u>		
	Scale: 4" = 1 MILE	Date: NOV 1993	Job: 1287-93
	Dsn:	 M. A. PALMER & SONS, INC. ENGINEERING & SURVEYING 254 N. Alder - Box 61 Burns, Oregon 97720	Sht. No.
Drn: CTP	of 1		
Ckd:			