



Property located on West half of Southeast Quarter of the Southwest Quarter of Section Thirty in Township Three North Range 40 East of Willamette Meridian in Union County, Oregon

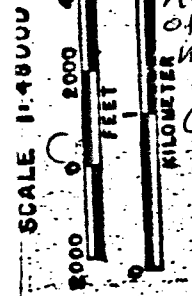


Property Above
Location of
Pavement

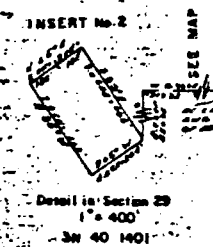

RECEIVED
DEC 11 1992
STATE OF OREGON
SAL DIV.

#2
230' from the North East Corner
#1
220' from the South East Corner West

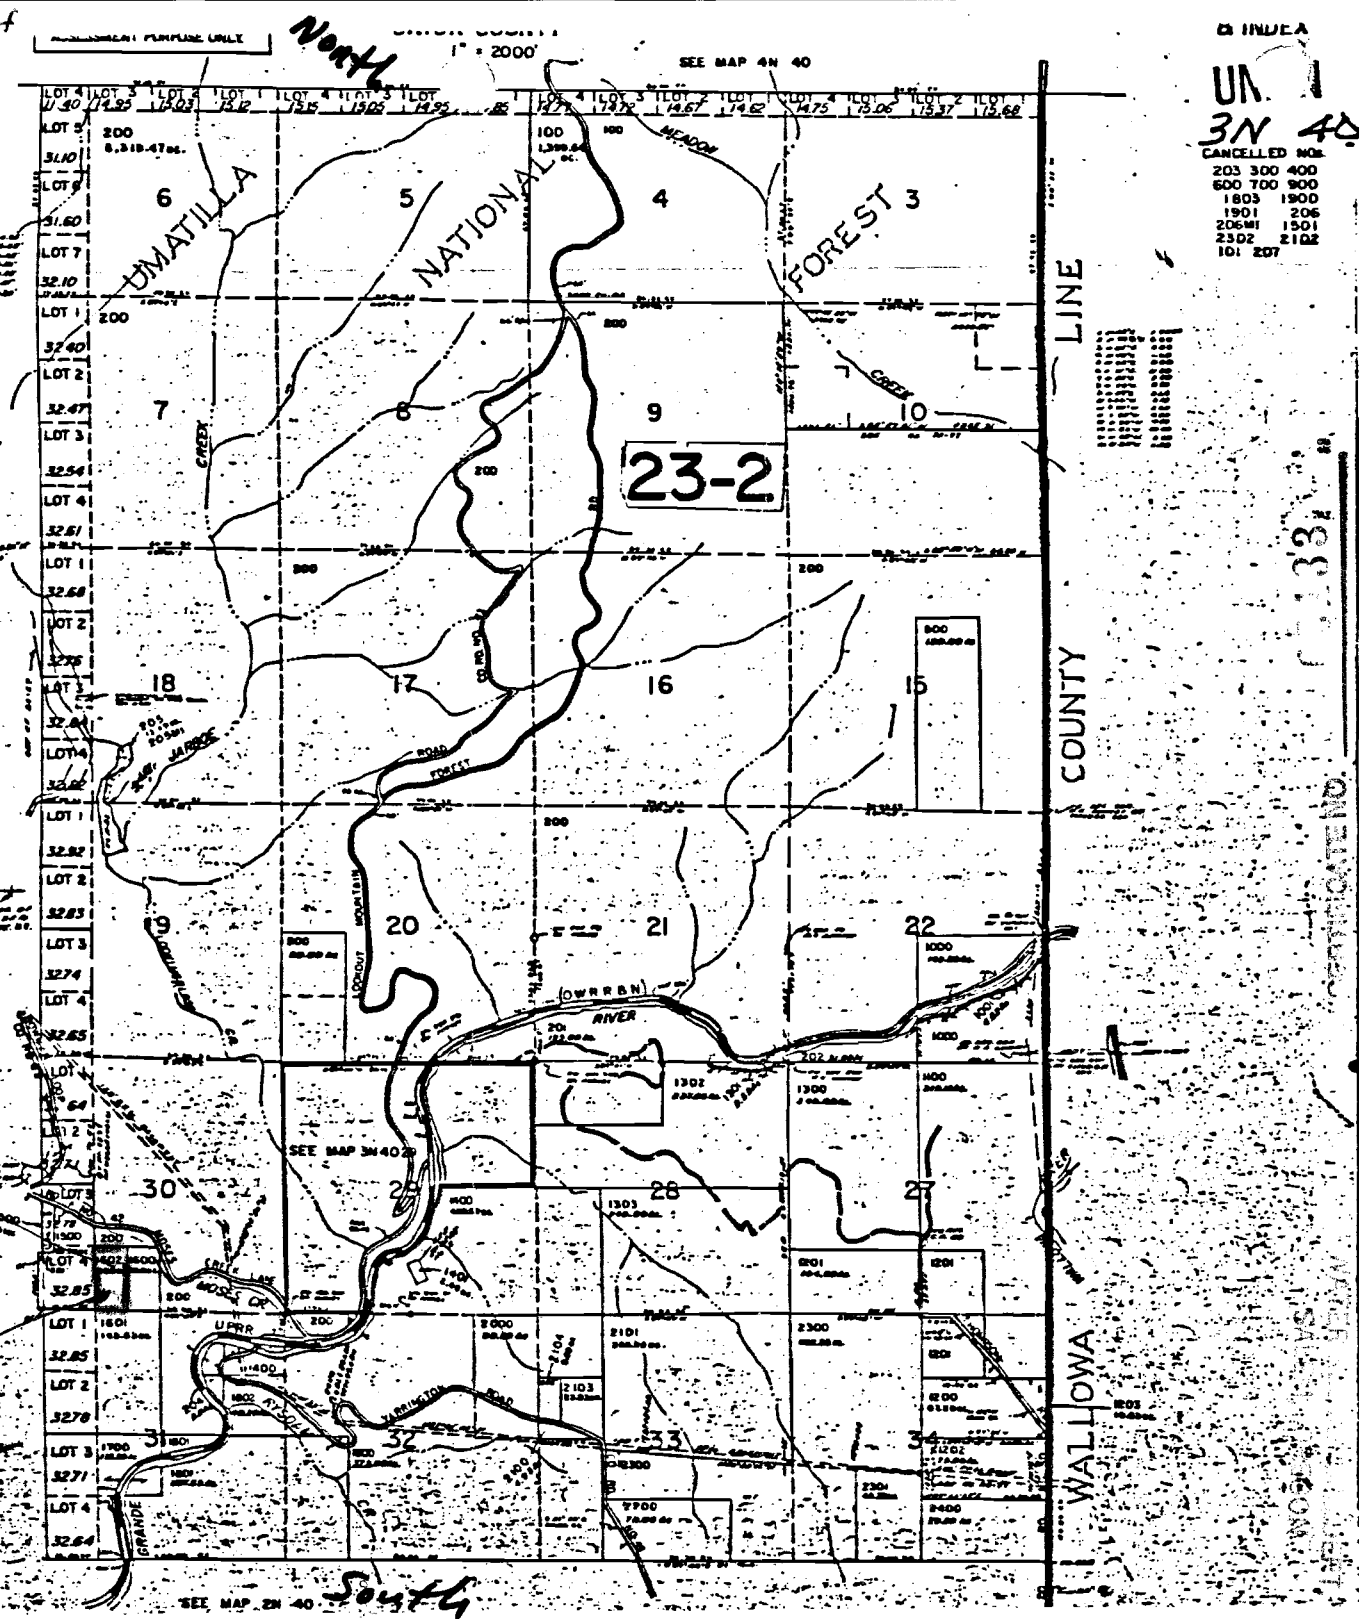

INDEX
UN. 1
3N 40
CANCELLED NOS.
203 300 400
600 700 800
1803 1900
1901 206
206 1501
2302 2102
101 207

106-2-74019
Permit No.
APR 16 1994