


GASS RESERVOIR APPLICATION MAP

SECTION 7 T.4N. R.29E.W.M.
UMATILLA COUNTY
FILED UNDER HP2153

RECEIVED

WATER RESOURCES DIVISION
WILSON, OREGON

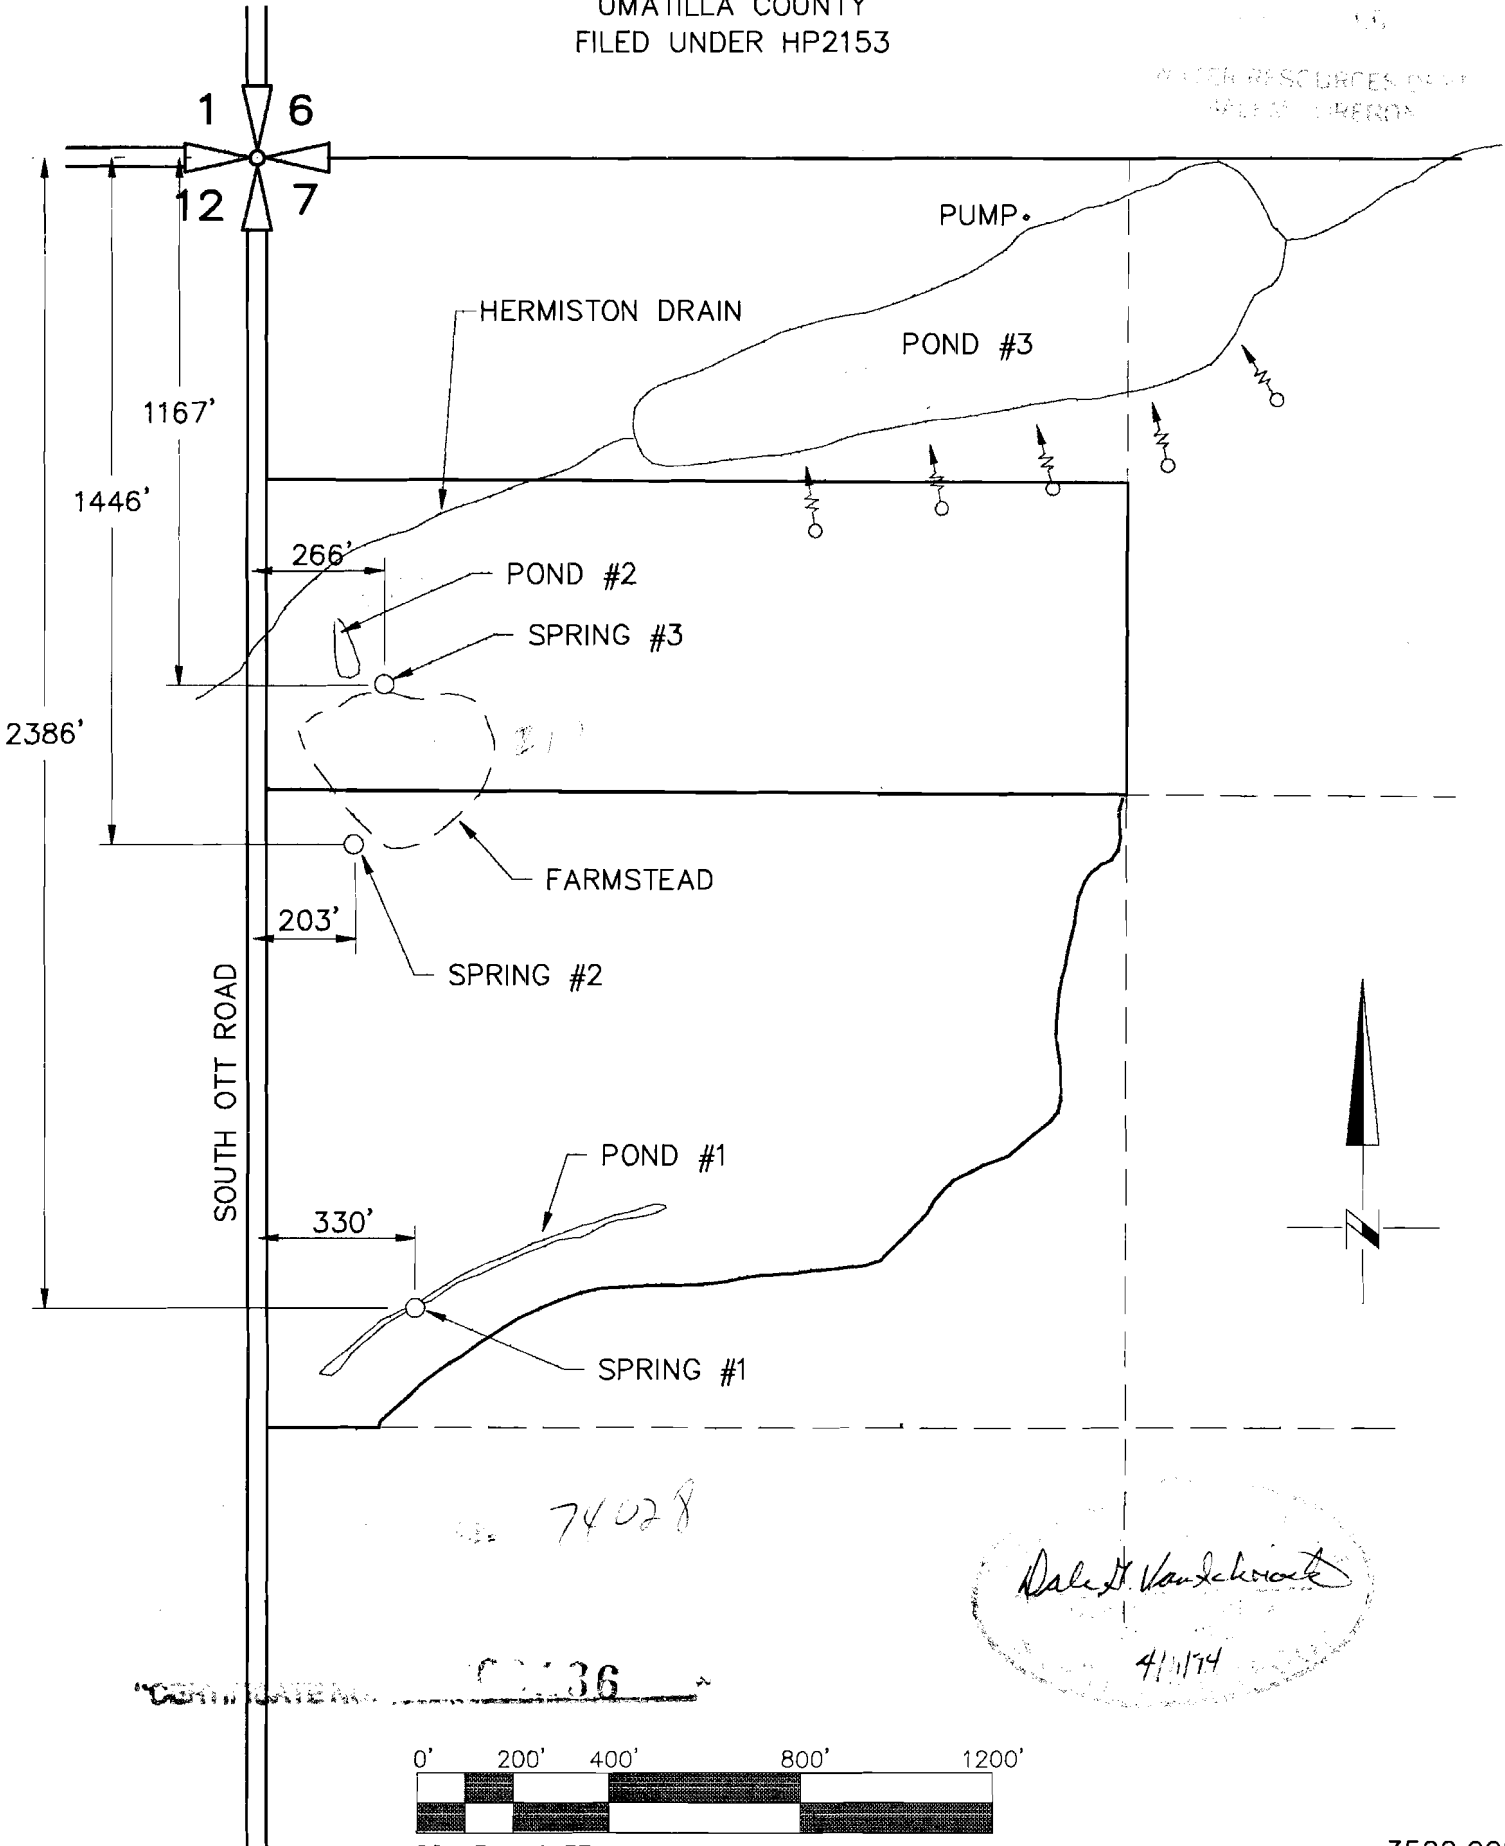

SCALE IN FEET

3522.008