

Hillcrest Corp.
Mountcrest Tree Farm

UNITED STATES

DEPARTMENT OF THE INTERIOR JUL 22 1994


GEOLOGICAL SURVEY

Jackson County, Oregon

1 420 000 | FEET (OREG.)

122° 7' 30" Jackson County, 532000m E

533 840 000 FEET (CALIF.) 534

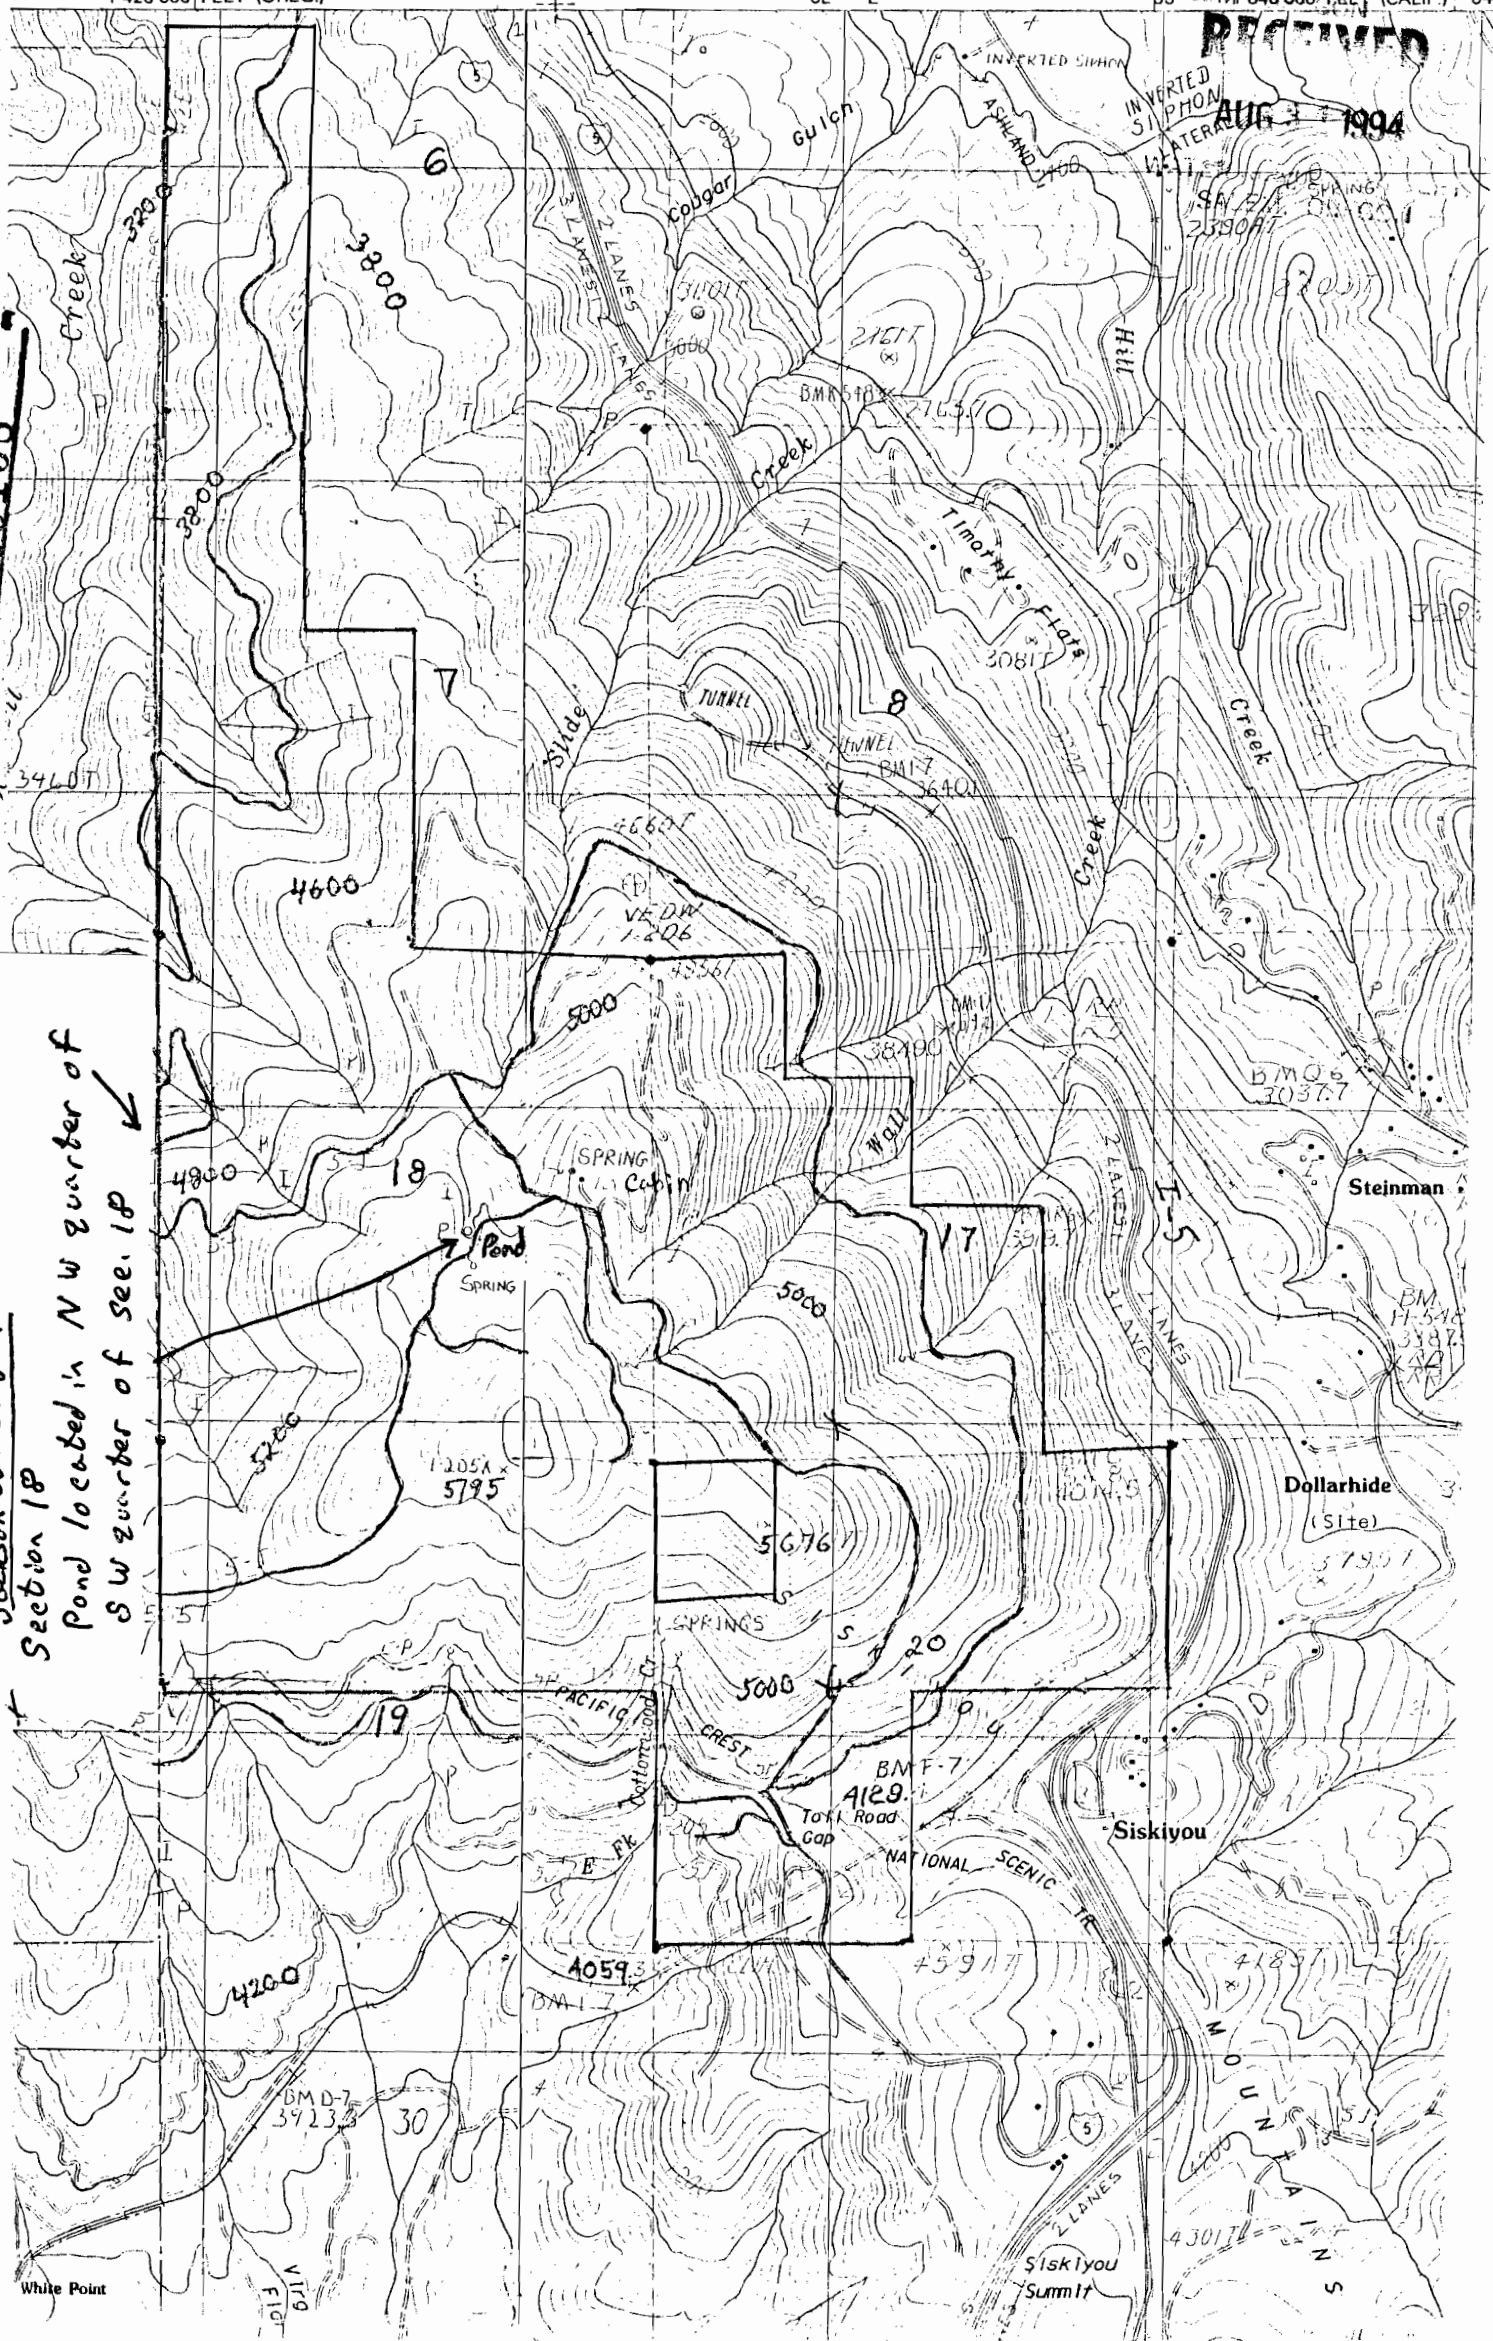

No Final Proof Map available

No Permit Map available