

N'E 1/4 OF NW 1/4
SEC 32A T 25S R 5W WM

MAY - 4 1994


WATER RESOURCES DEPT.
SALEM, OREGON

NE1/4 SEC
DO

THIS MAP WAS PREPARED FOR
ASSESSMENT PURPOSE ONLY.

WATER RESOURCES
DEPARTMENT
SALEM, OREGON

SEE MAP 25

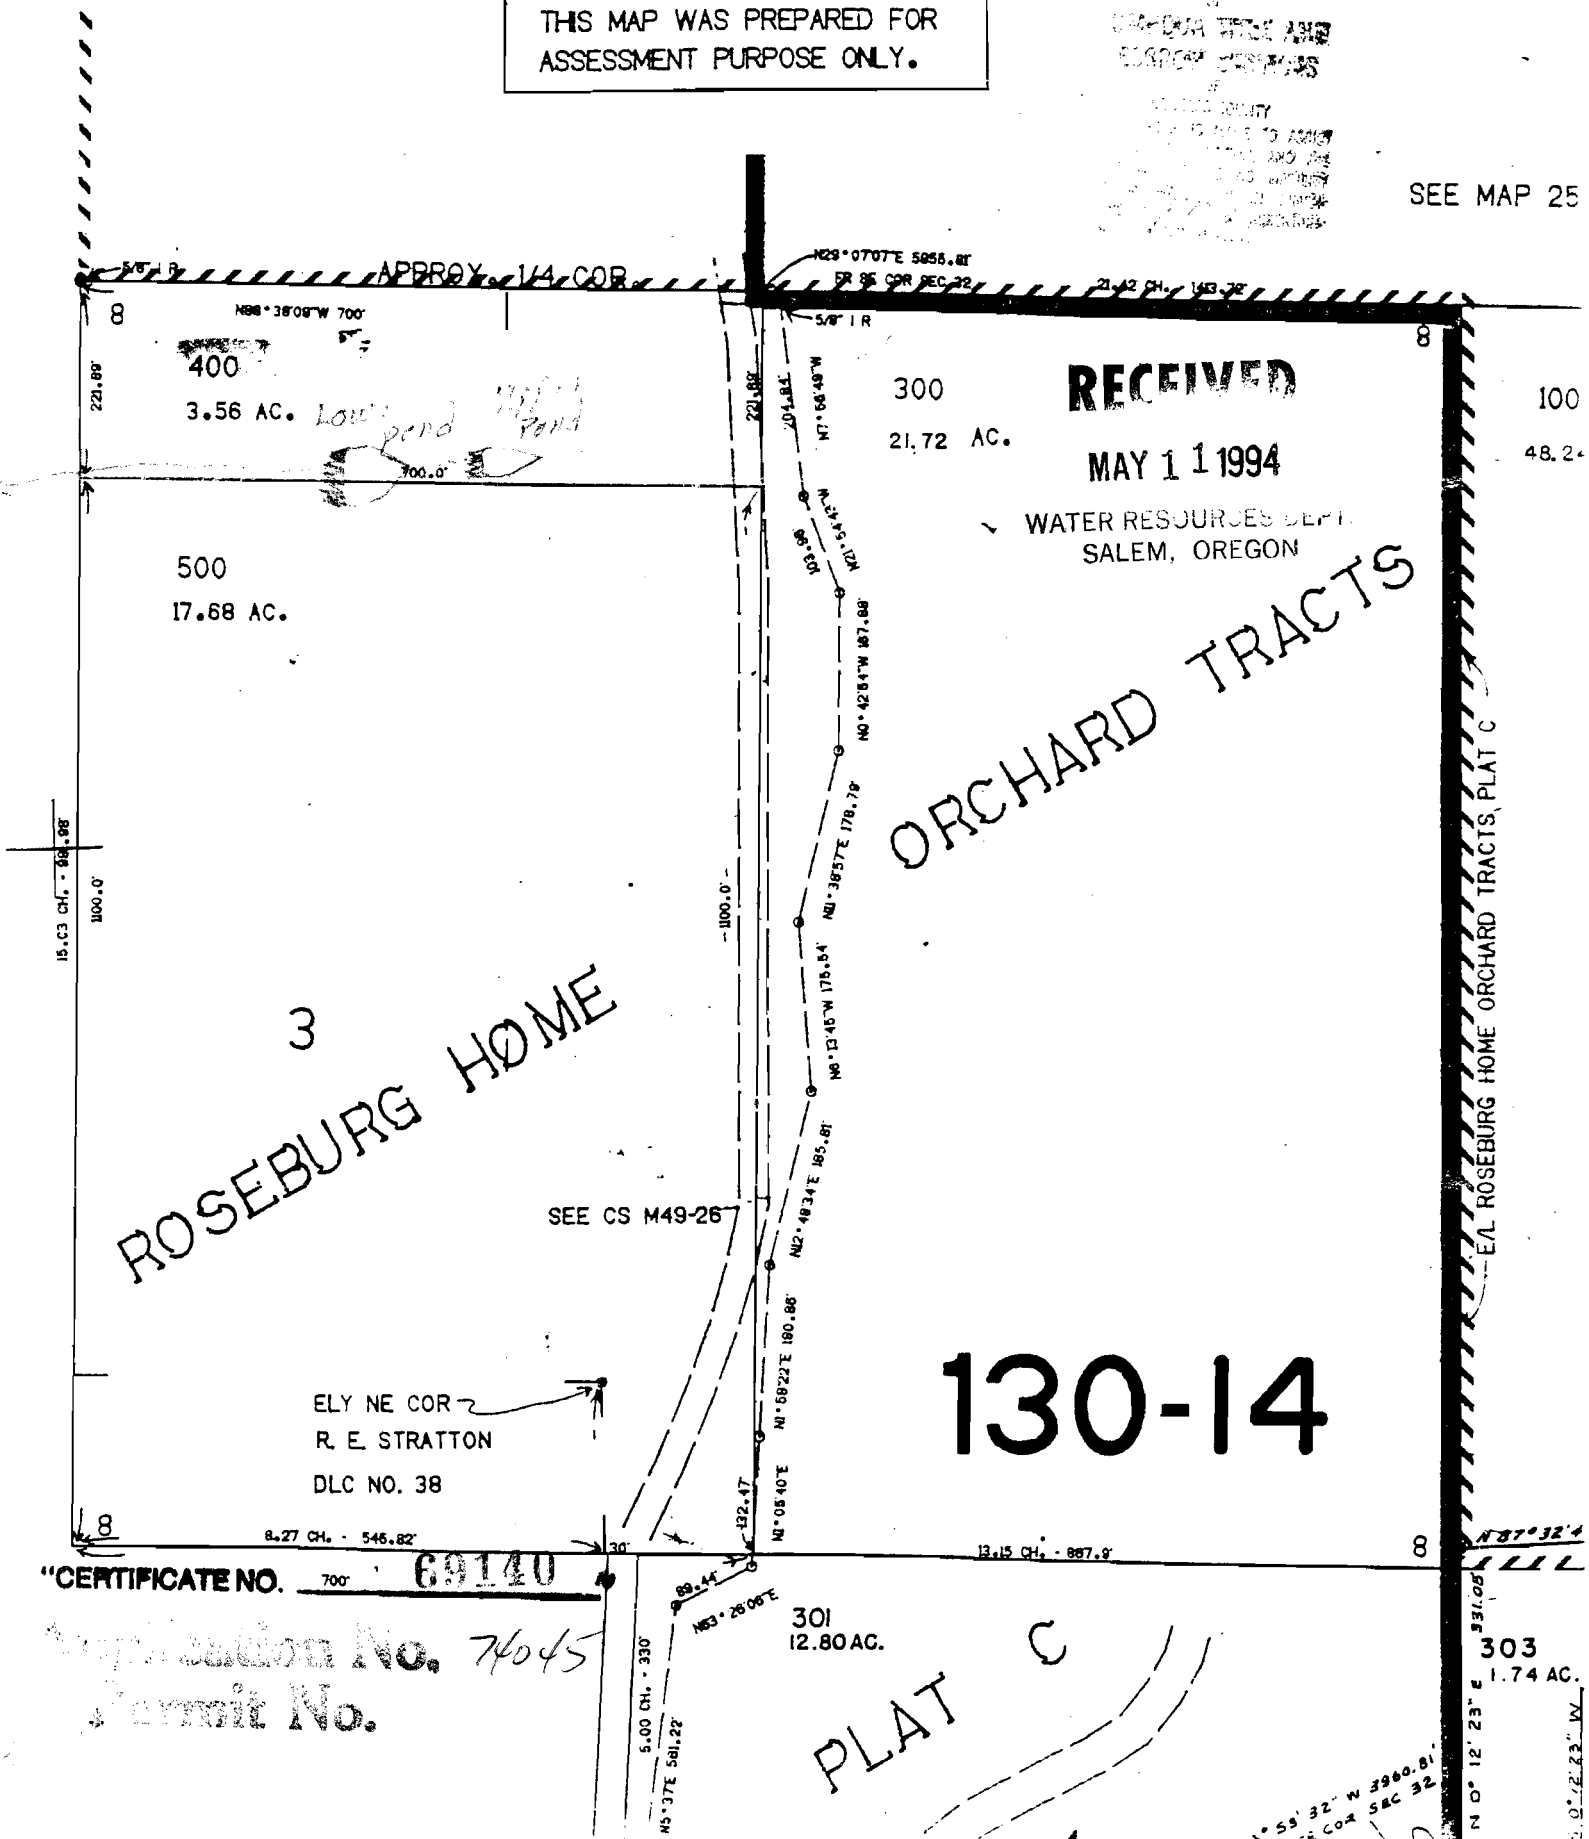

RECEIVED

MAY 11 1994

WATER RESOURCES DEPT.
SALEM, OREGON

ORCHARD TRACTS

130-14

SEE CS M49-26

ELY NE COR
R. E. STRATTON
DLC NO. 38

"CERTIFICATE NO. 69140"

Application No. 74045
Permit No.

PLAT C

303
1.74 AC.