

SE1/4 SEC.13 T.25S. R.5W. W.M.
DOUGLAS COUNTY

SSW COR
DLC 442
3.25 CH.
SE COR
STATION
DL. 43

25 5 13D

Application No. 74001
Permit No.


THIS MAP WAS PREPARED FOR
ASSESSMENT PURPOSE ONLY.

1"=200'

REVISED ON
5-08-91

CEN. SEC.

SEE MAP 25 5 13A

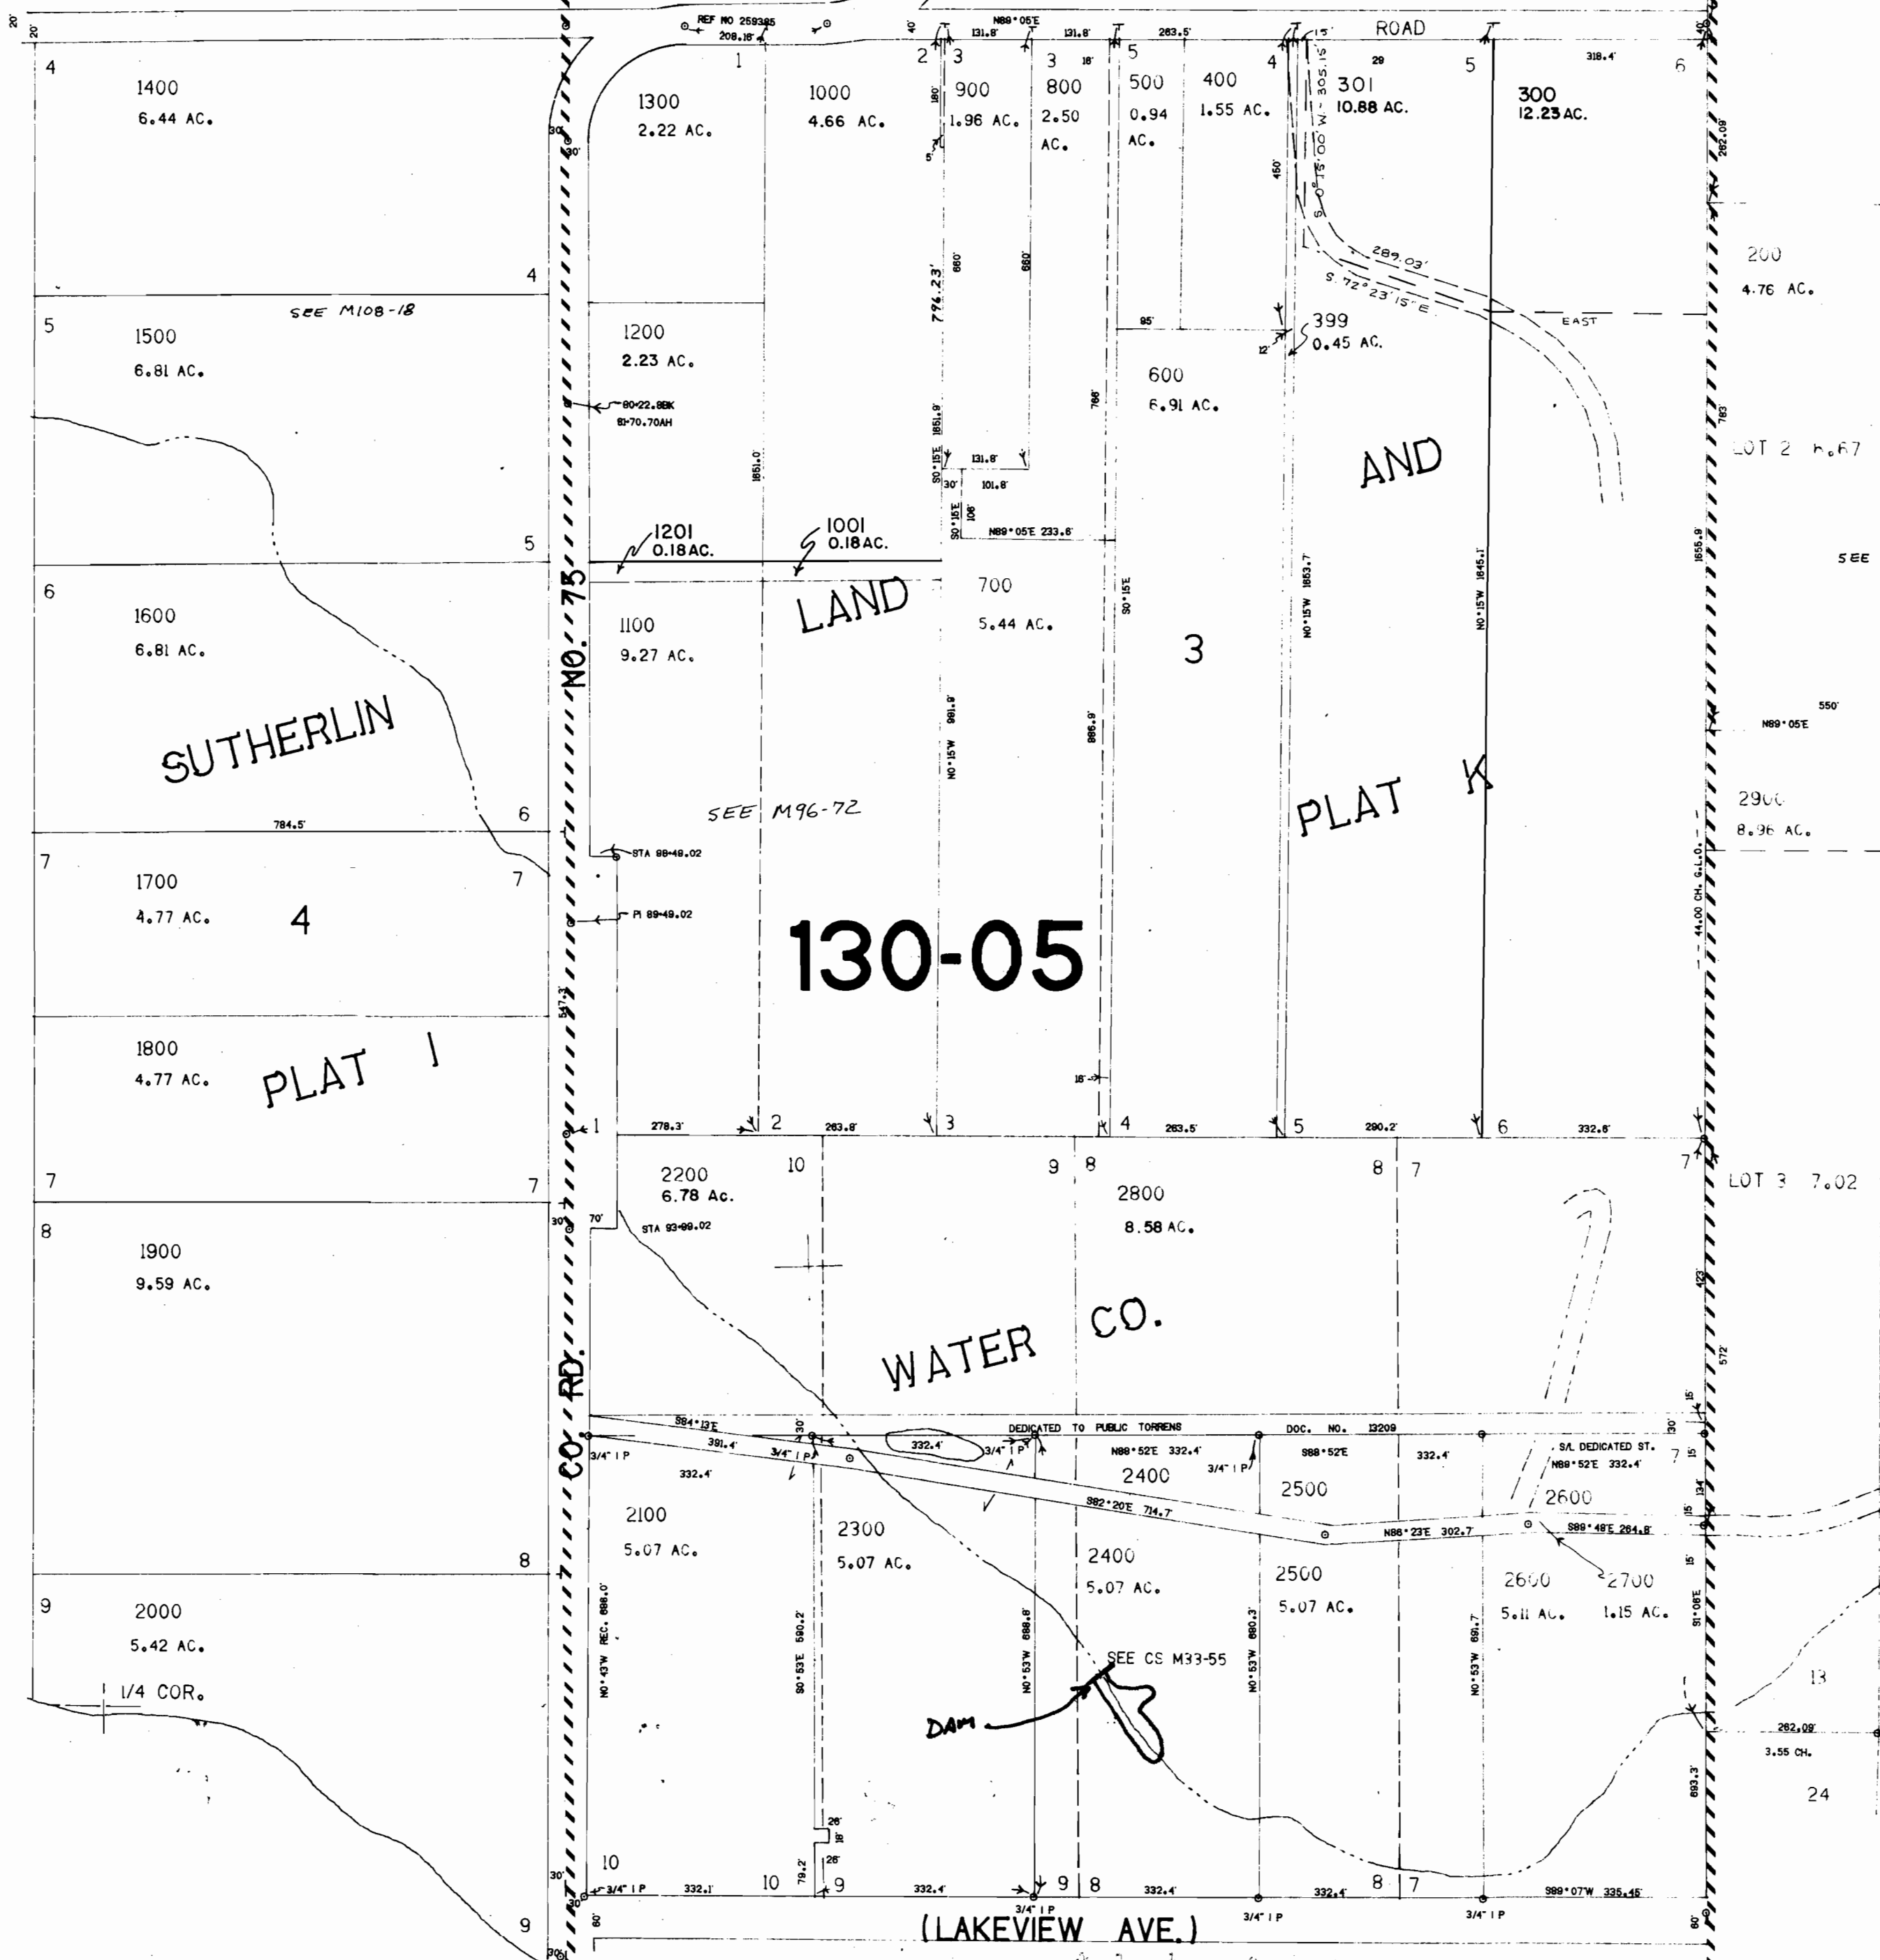

SEE MAP 25 5 13C

SEE MAP 25 4 15

DAM- 80'N
1160'W
FROM SE COR
SEC 13

130-05

SEE MAP 25 5 24A

Application No. 74001
"CERTIFICATE NO. 69143"

25 5 13D

CONTROL 8-79 LAYOUT 8-79 TRACED 2-80 CHECKED 15

No Final Proof Map available

No Permit Map available