


DETAIL MAP NO. 2 T.3S. R.44E. W.M.  
WALLOWA COUNTY

3S 44  
DETAIL MAP NO. 2

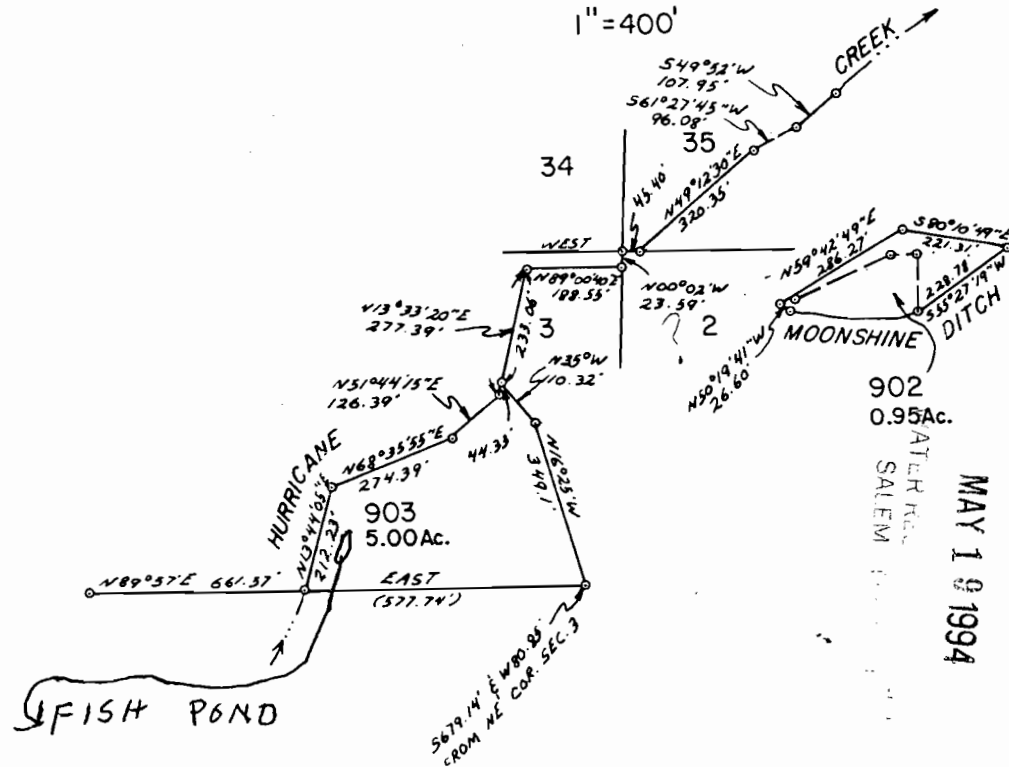

MAY 19 1994

RECEIVED

CERTIFICATE NO. 69144

MAR 28 1994  
WATER RESOURCES DEPT.  
SALEM, OREGON

AUG - 8 1996  
WATER RESOURCES DEPT.  
SALEM, OREGON

RECEIVED

No Final Proof Map available

No Permit Map available