


L. J. Enaglien
 17405 Brown Rd.
 Dallas, OR. 97338

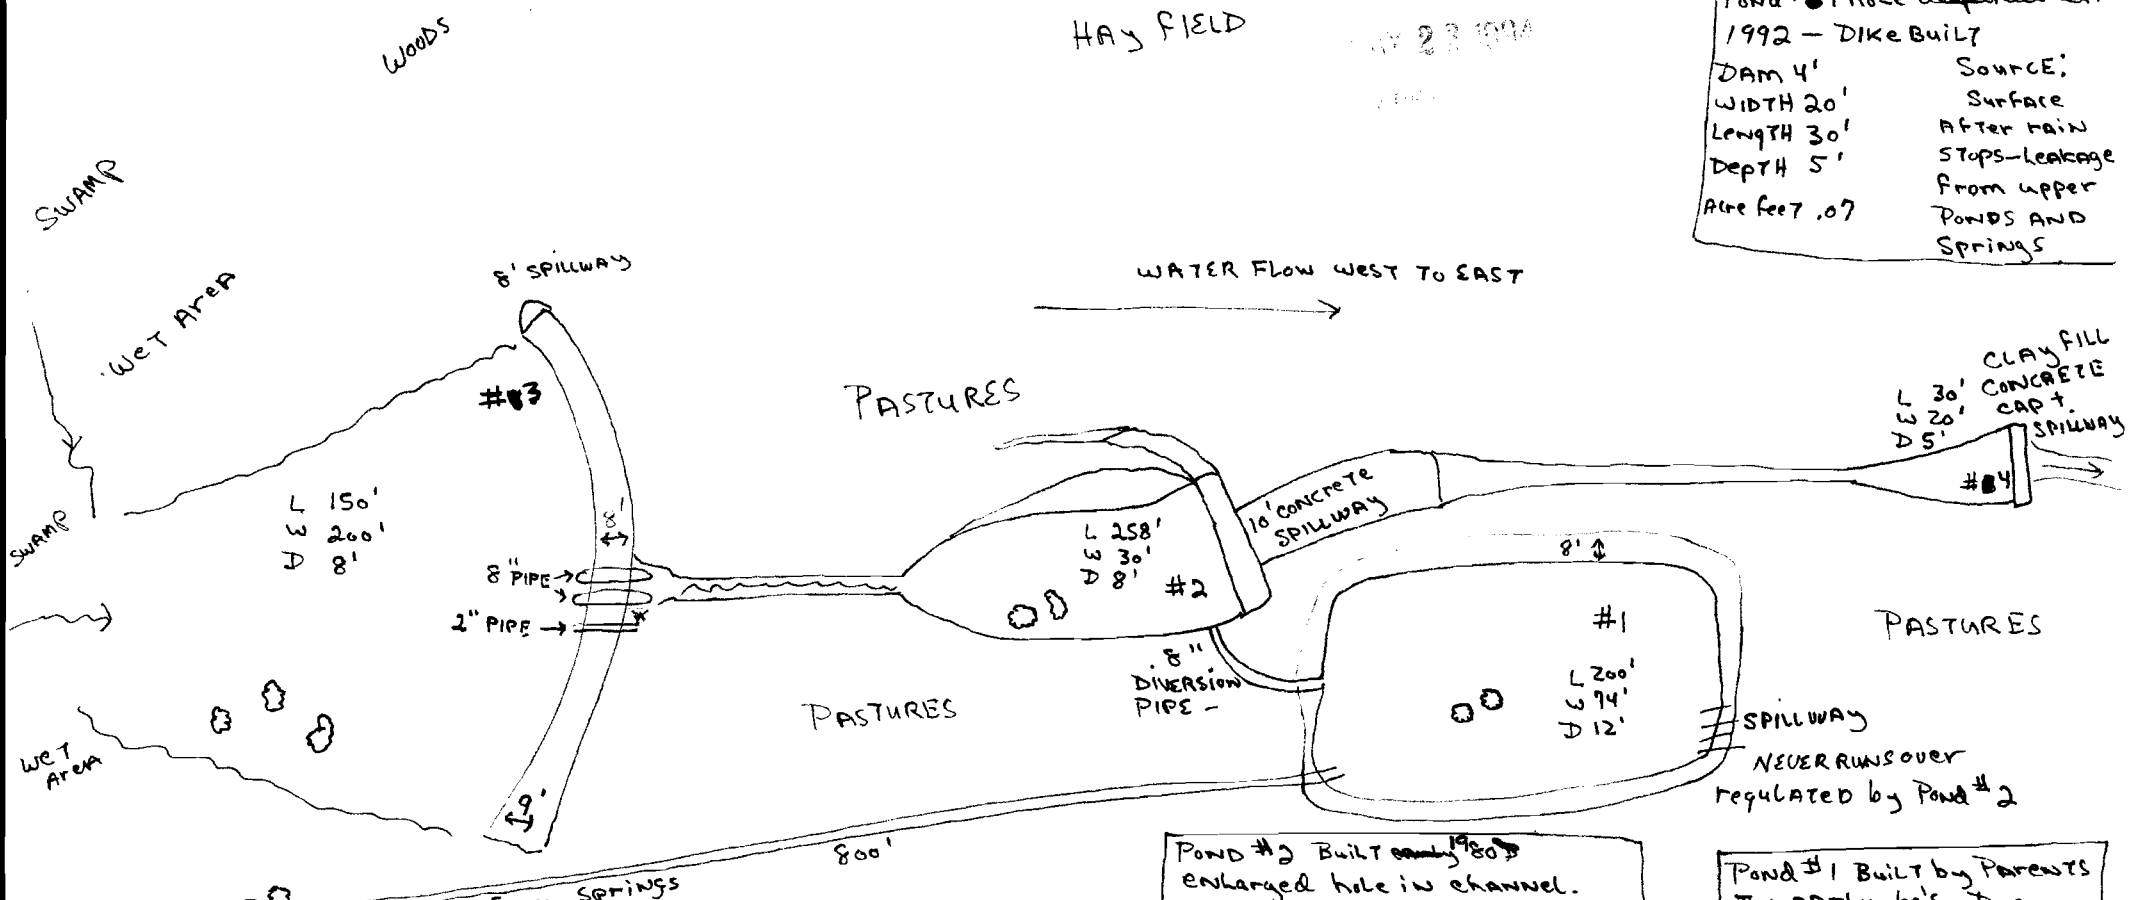

Pond #4 hole deepened in 1992 - DIKE BUILT
 DAM 4' Source: Surface
 WIDTH 20' After rain
 LENGTH 30' Stops-leakage
 DEPTH 5' From upper
 Ponds AND
 Springs
 Acre feet .07

Pond #3 BUILT 1988 by enlarging
 AND scooping out wet area
 SPRINGS FOUND - 20-30 GPM
 DAM 8' Source: Surface
 Length 150' Seepage
 WIDTH 200' Springs
 Depth 8'
 ACRE FEET 5.51

Pond #2 BUILT early 1980's
 enlarged hole in channel.
 IN 1992 was enlarged
 again.
 DAM 4' Source: Surface
 Length 258' Springs
 Width 30' Seepage from
 Depth 8' #4
 ACRE FEET 1.42

Pond #1 BUILT by Parents
 In early 60's. Dug
 Deeper in 1980.
 DAM 8' Source: Surface
 Length 200' Springs
 Width 74' Pond #2
 Depth 12' Inflow
 ACRE FEET 4.08 CONTROLLED

☉ = denotes springs

Application No. R-74066
 Permit No.

"CITY OF DALLAS" NO. 07146