

SEC. 16 T.3N. R.2W. W.M.
COLUMBIA COUNTY
THIS MAP HAS BEEN PREPARED FOR ASSESSMENT PURPOSES ONLY
Scale: 1" = 400' Current Revision Date: 1/13/87

SCALE 1:2500




TRACTS

SECTION NO. 0147

RECEIVED

MAY 24 1994

WATER RESOURCES DEPT.
SALEM, OREGON

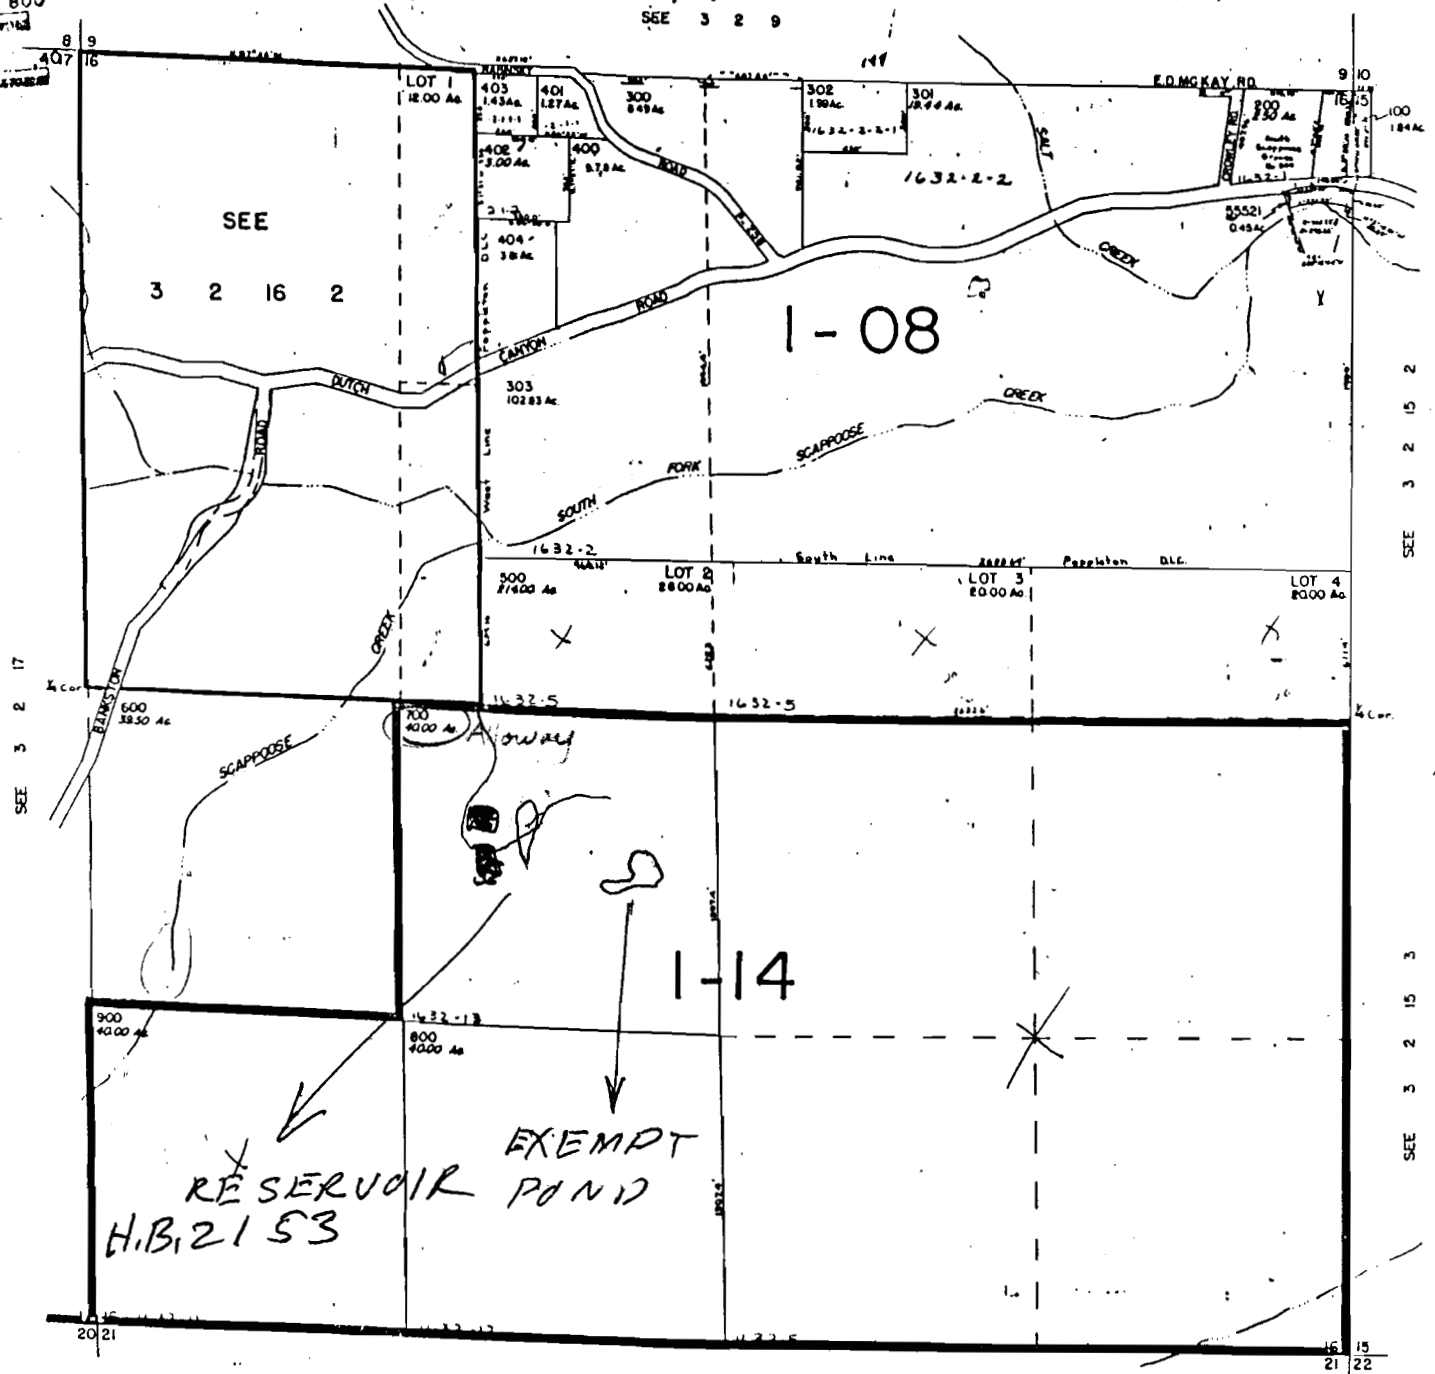

SEC. 16 T.3N. R.2W. W.M.
 COLUMBIA COUNTY
 THIS MAP HAS BEEN PREPARED FOR ASSESSMENT PURPOSES ONLY
 Scale: 1" = 400' Current Revision Date: 1/13/87

SCALE 1:2500



RTRACTS

01147

CERTIFICATE NO.

RECEIVED

MAY 24 1994
 WATER RESOURCES DEPT.
 SALEM, OREGON

