

T. 29 S. R. 7 W. SEC. 2

3 2

RECEIVED

MAY 13 1994

WA. SOURCES DEPT.
SALEM, OREGON

(3)

RECEIVED

MAY 26 1994


WATER RESOURCES
SALEM, OREGON

(1)

(1)
73-1853

2 1

12062-00

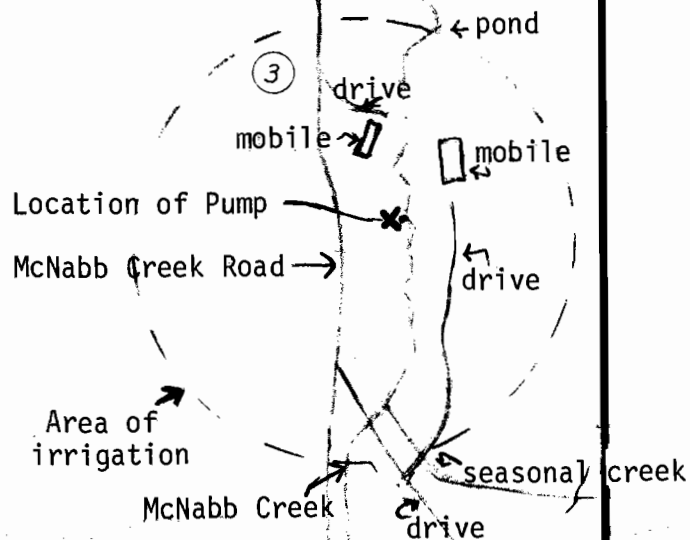

39⁸⁰00

30⁵⁵00

39⁴²00

(2)
75-7942

(2)

(2)

The Southwest quarter of the Northwest quarter of
Section 2, Township 29 South, Range 7 West,
Willamette Meridian, Douglas County, Oregon

(4)

(2)
77-16543

(2)

(2)
75-7937

12063-01

(4)

12043-11
90-0179

(5)

3 2

2 1

10 11

11 12

R74082

"CERTIFICATE NO. 69149"

Application 6-1-1994