R74202-

RECEIVED

JUN 13 1994

WATER RESOURCES DEPARTMENT
SALEM, OREGON

QUAD - THORN HOLLOW

T - 3N

R - 35E

SCALE
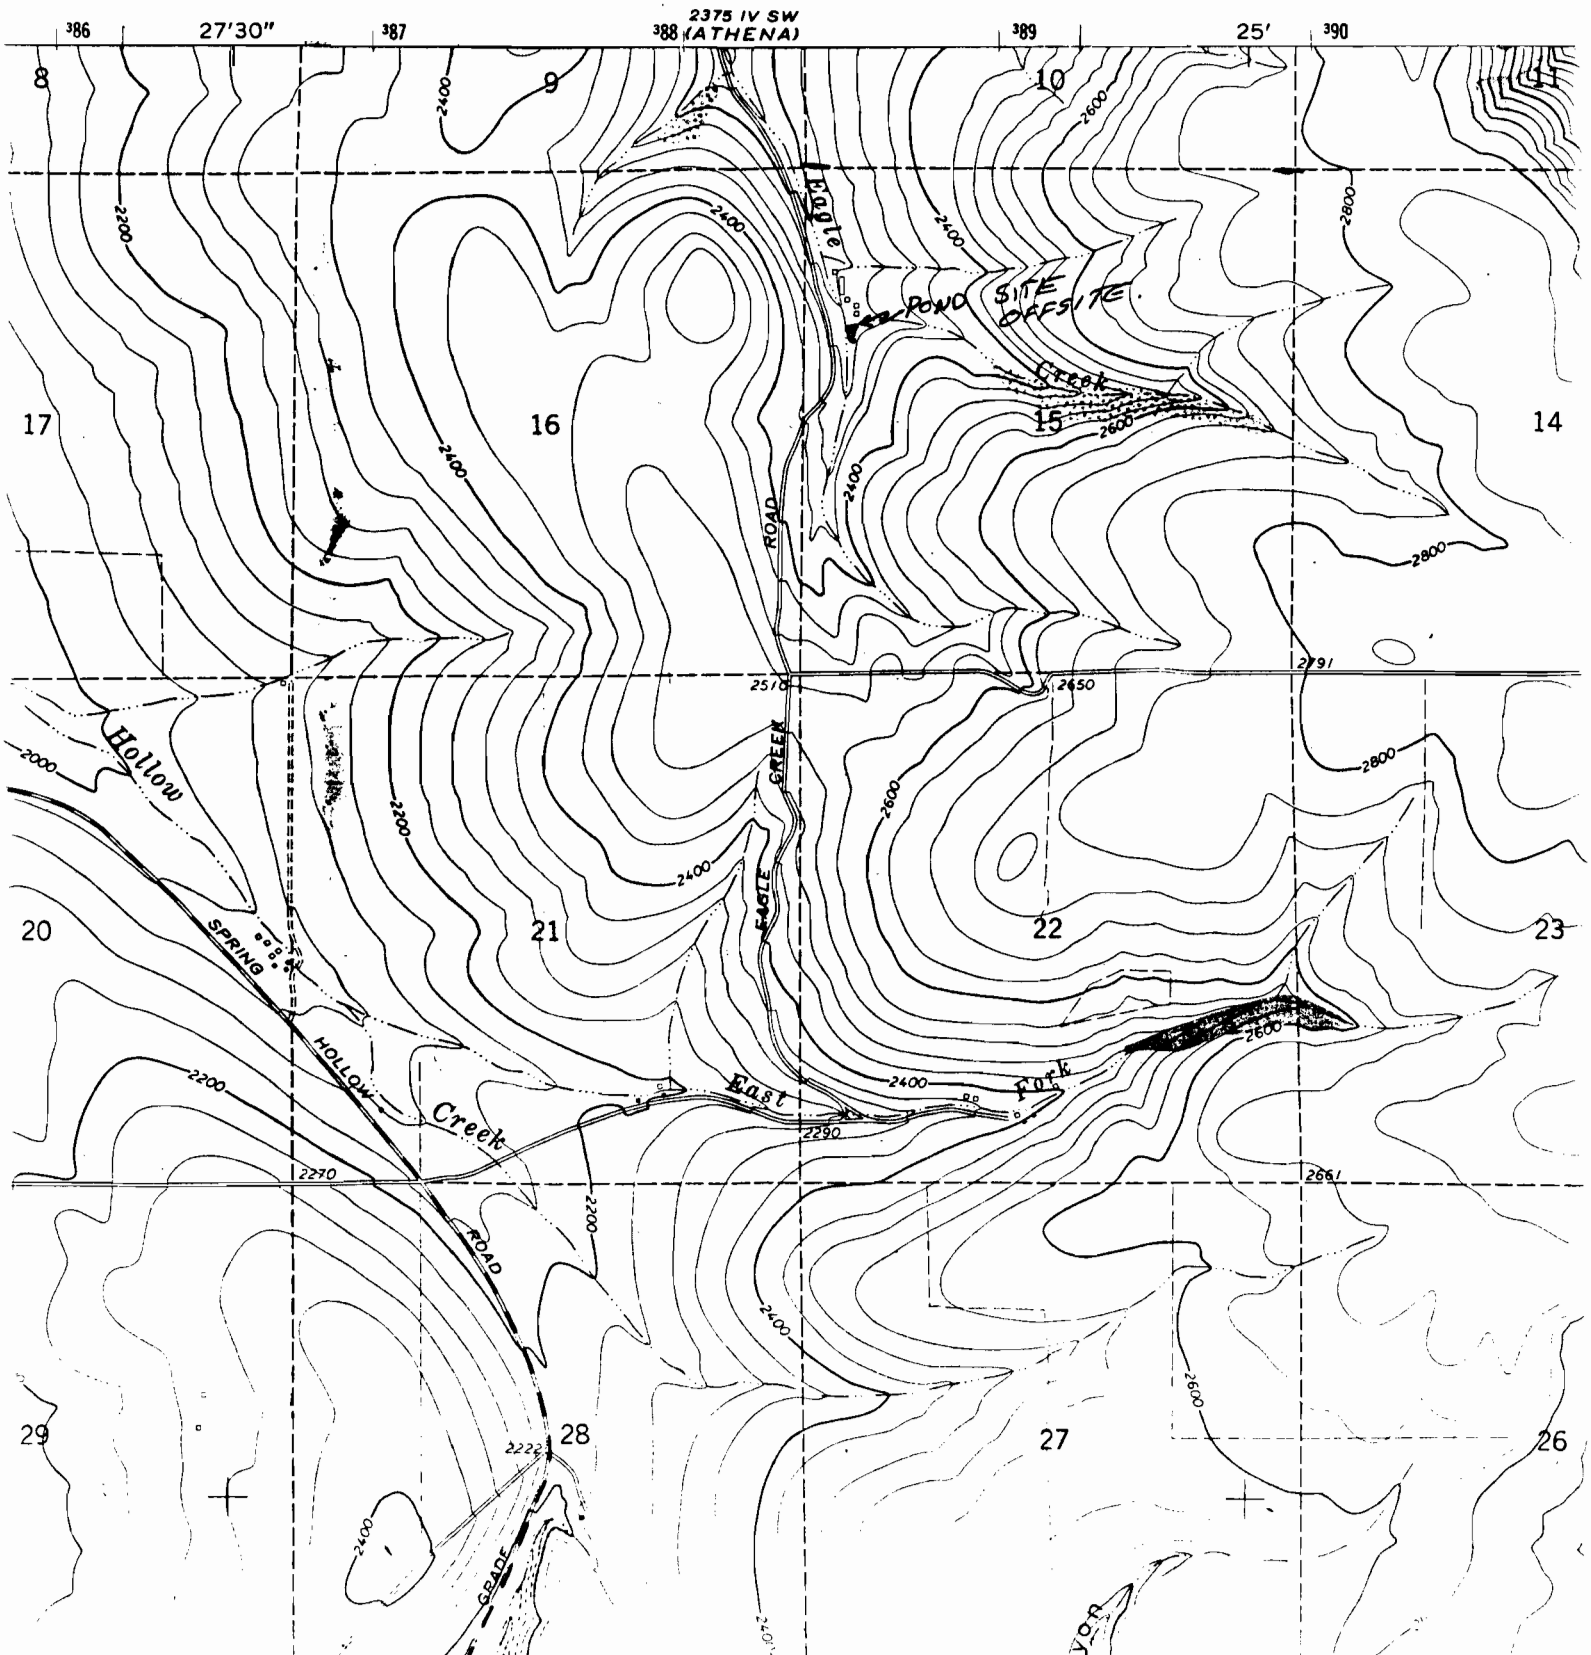
1" = 2000'