

T38S R20 E

W-47

Application No. R-74312

Permit No.

CERTIFICATE NO.

00037

T-504

HEL

HEL

HEL

PRANG RD 21

21 22

28

27

104-5
90-53

4/71 NHFL

6/09 NHFL

(1)

5/163

7/1023


SECTION

TOWNSHIP 38S, RANGE 20E, W. M.

RECEIVED

JUL 22 1994

North

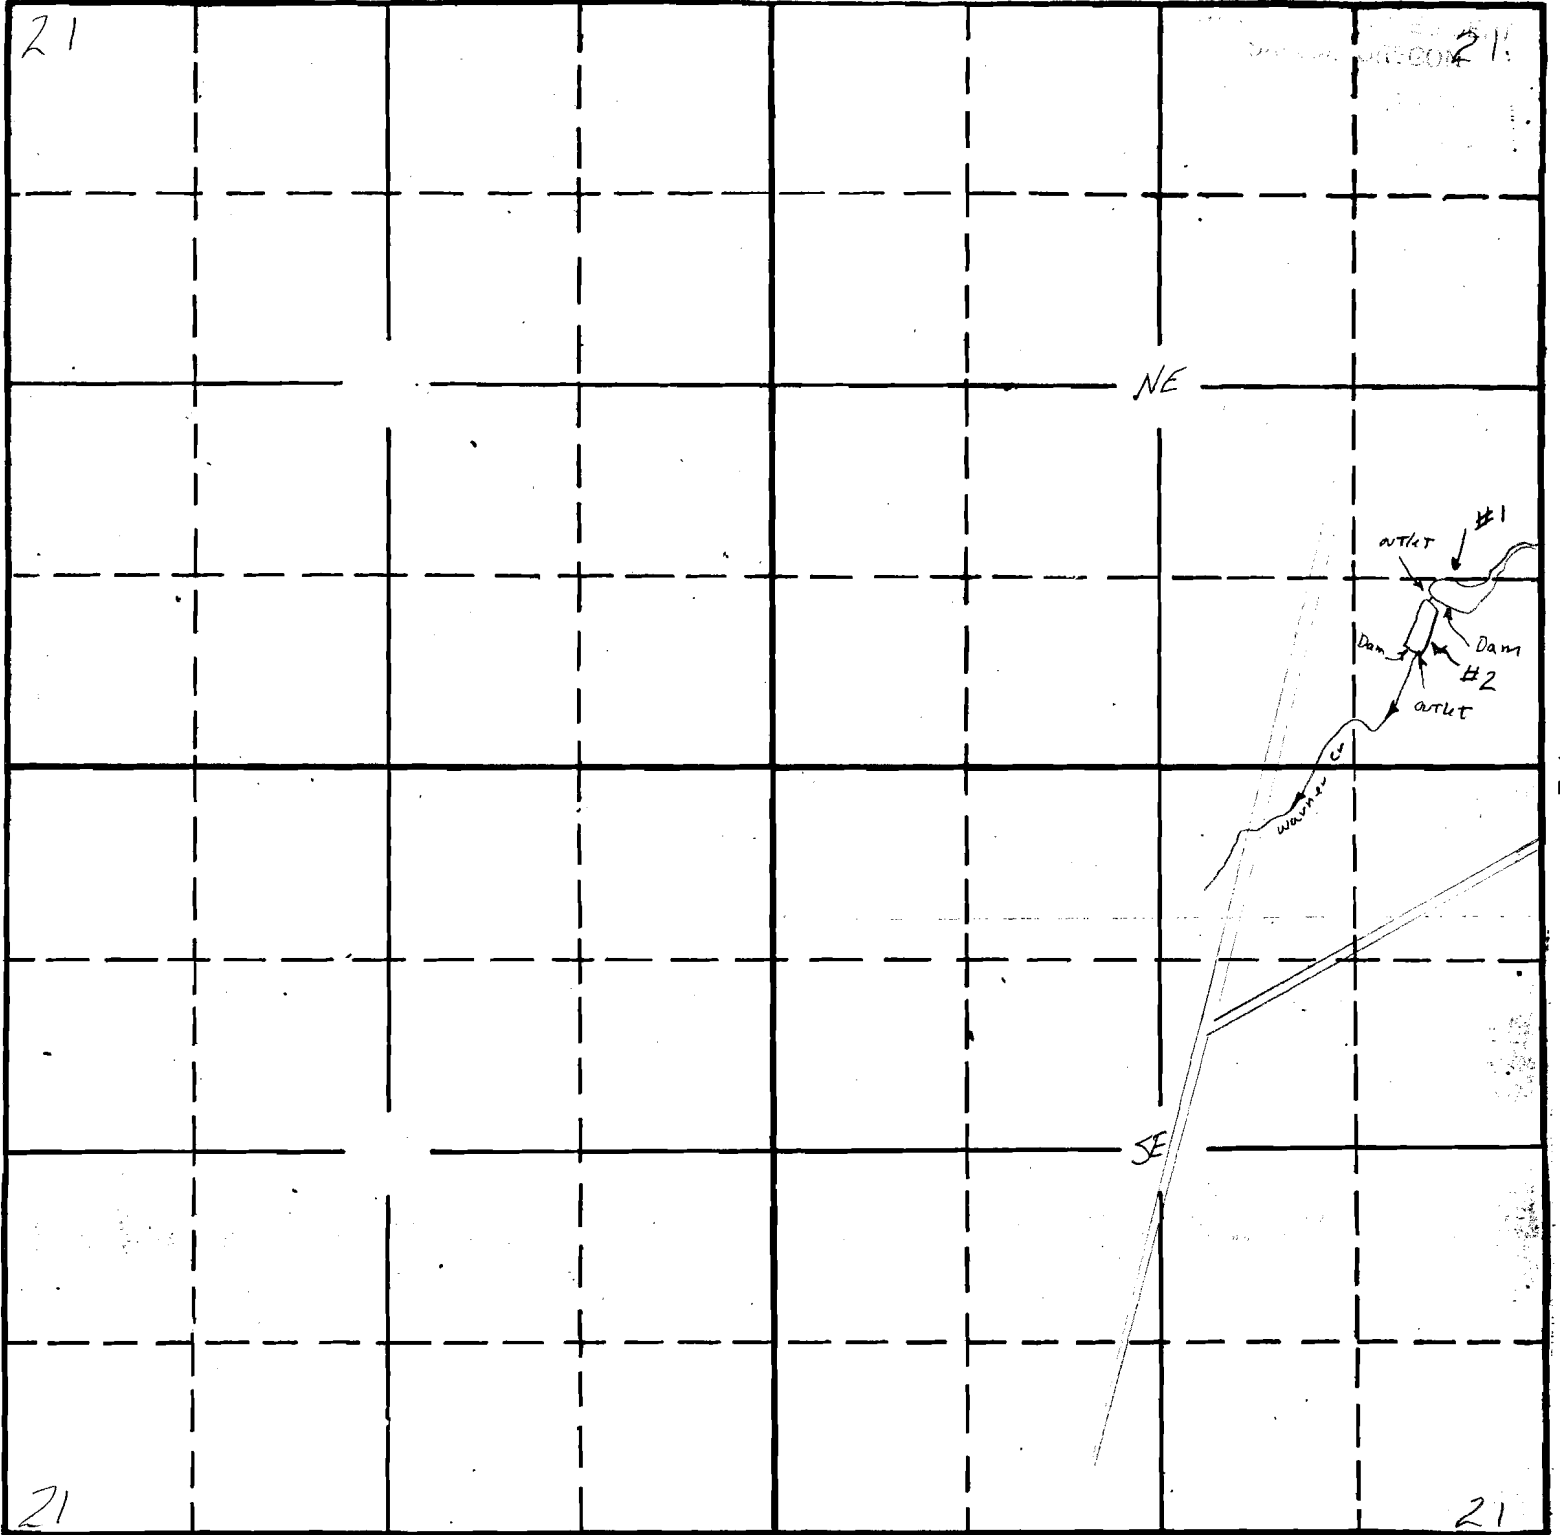

Scale 8" = 1 mile

South

APPLICATION No. R-74312

PERMIT No.

CERTIFICATE NO. 03137

No Final Proof Map available

No Permit Map available