

CERTIFICATE NO. 69188

RECEIVED

JUL 13 1994

WATER RESOURCES DEPT.  
SALEM, OREGON

T. 27S. R. 7W. WM.

RECEIVED

SEP 22 1983

WATER RESOURCES DEPT.  
SALEM, OR.

WATER RESOURCES DEPT.  
SALEM, OREGON

JAN 2 1984

JAN 2 1984


RECEIVED

Application No. R-4313  
Permit No.

RECEIVED

JAN 10 1984

WATER RESOURCES DEPT.  
SALEM, OREGON

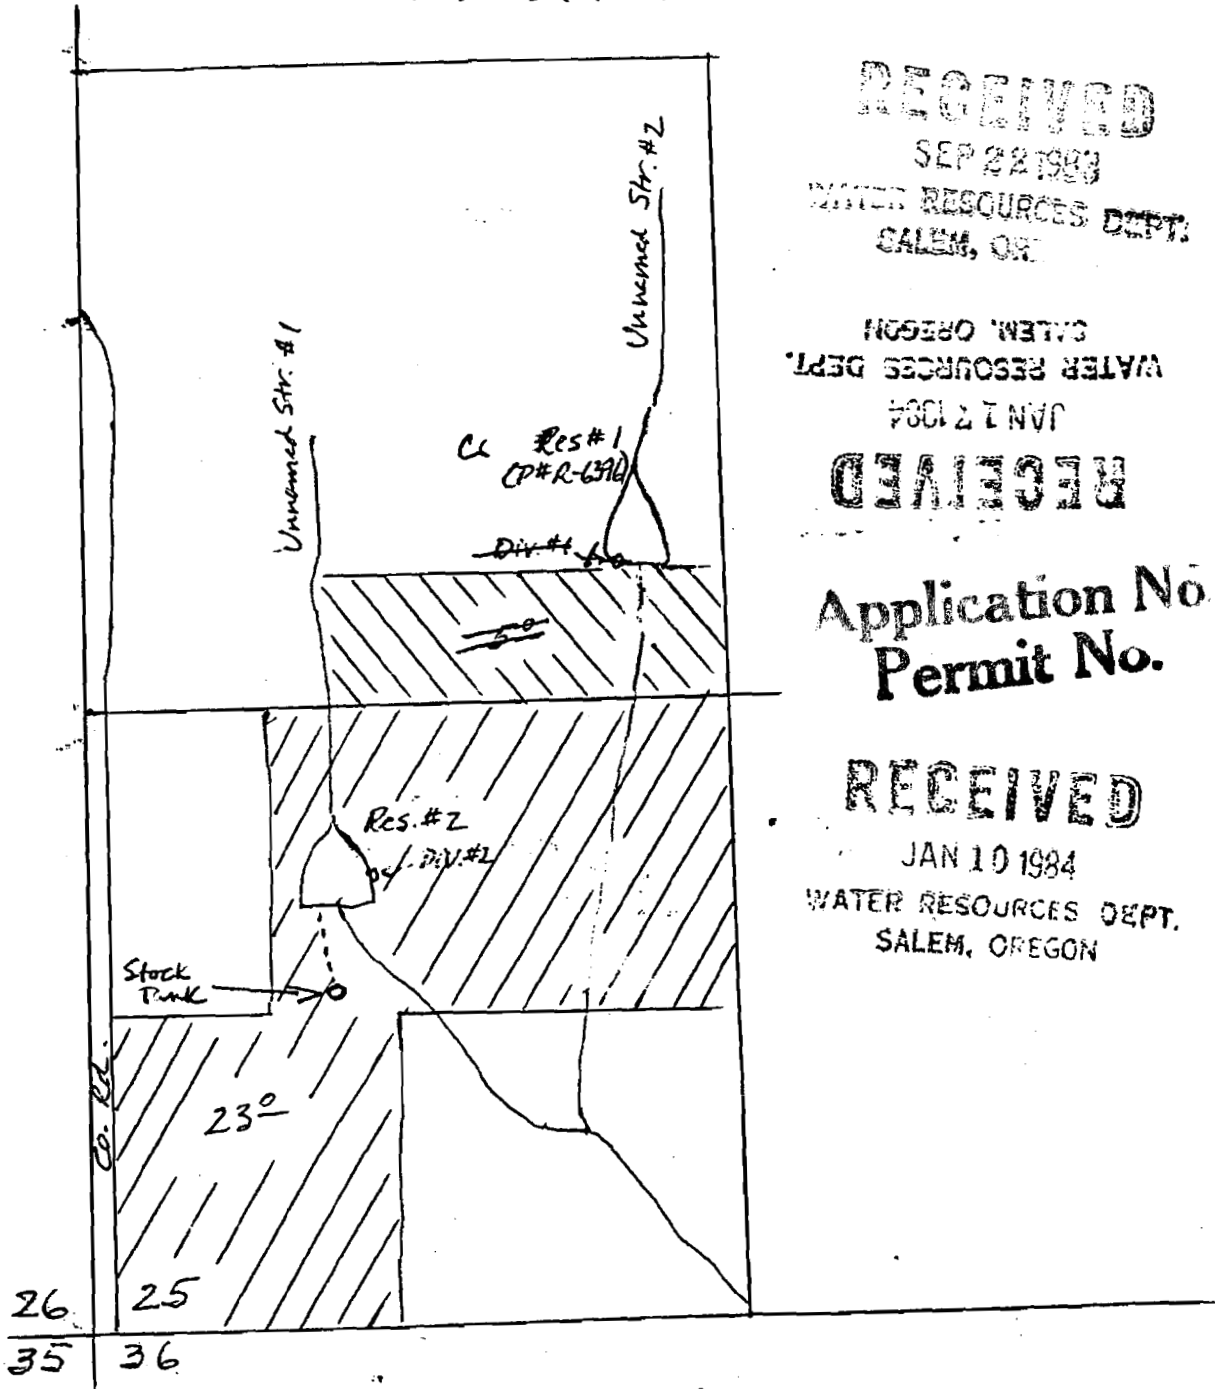

Scale: 1" = 400'

No Final Proof Map available

No Permit Map available