HB 2153

CERTIFICATE NO. 69191 R74324

Application No. R7432
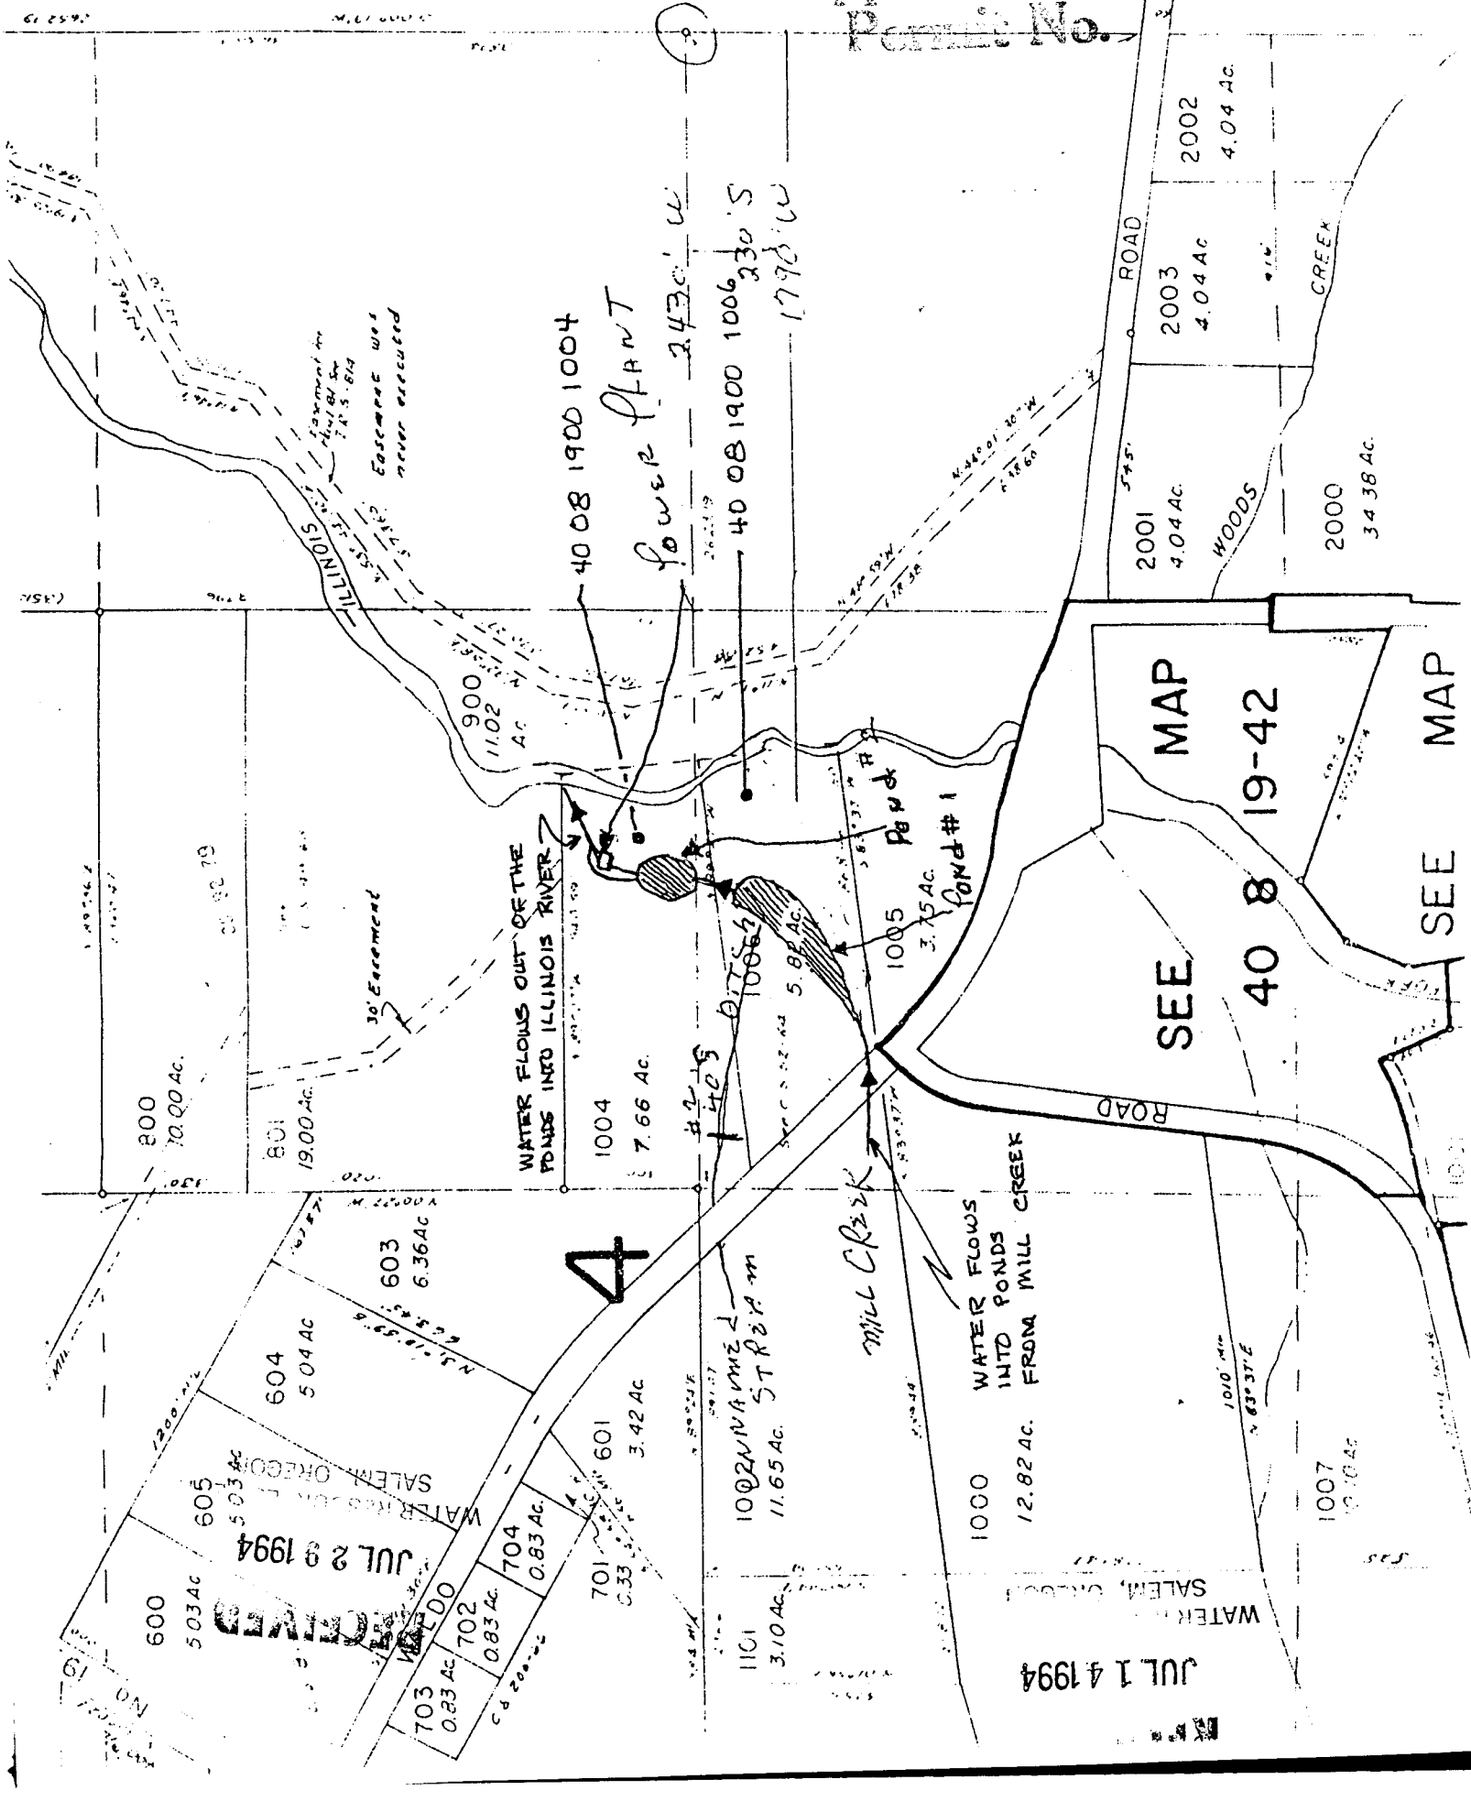
Permit No.