

tw
R.
SEC
1" = 4'

SEE MAP 40 8 20


13 2153

R74325

CERTIFICATE NO. 69192

Application No. R74

Permit No.

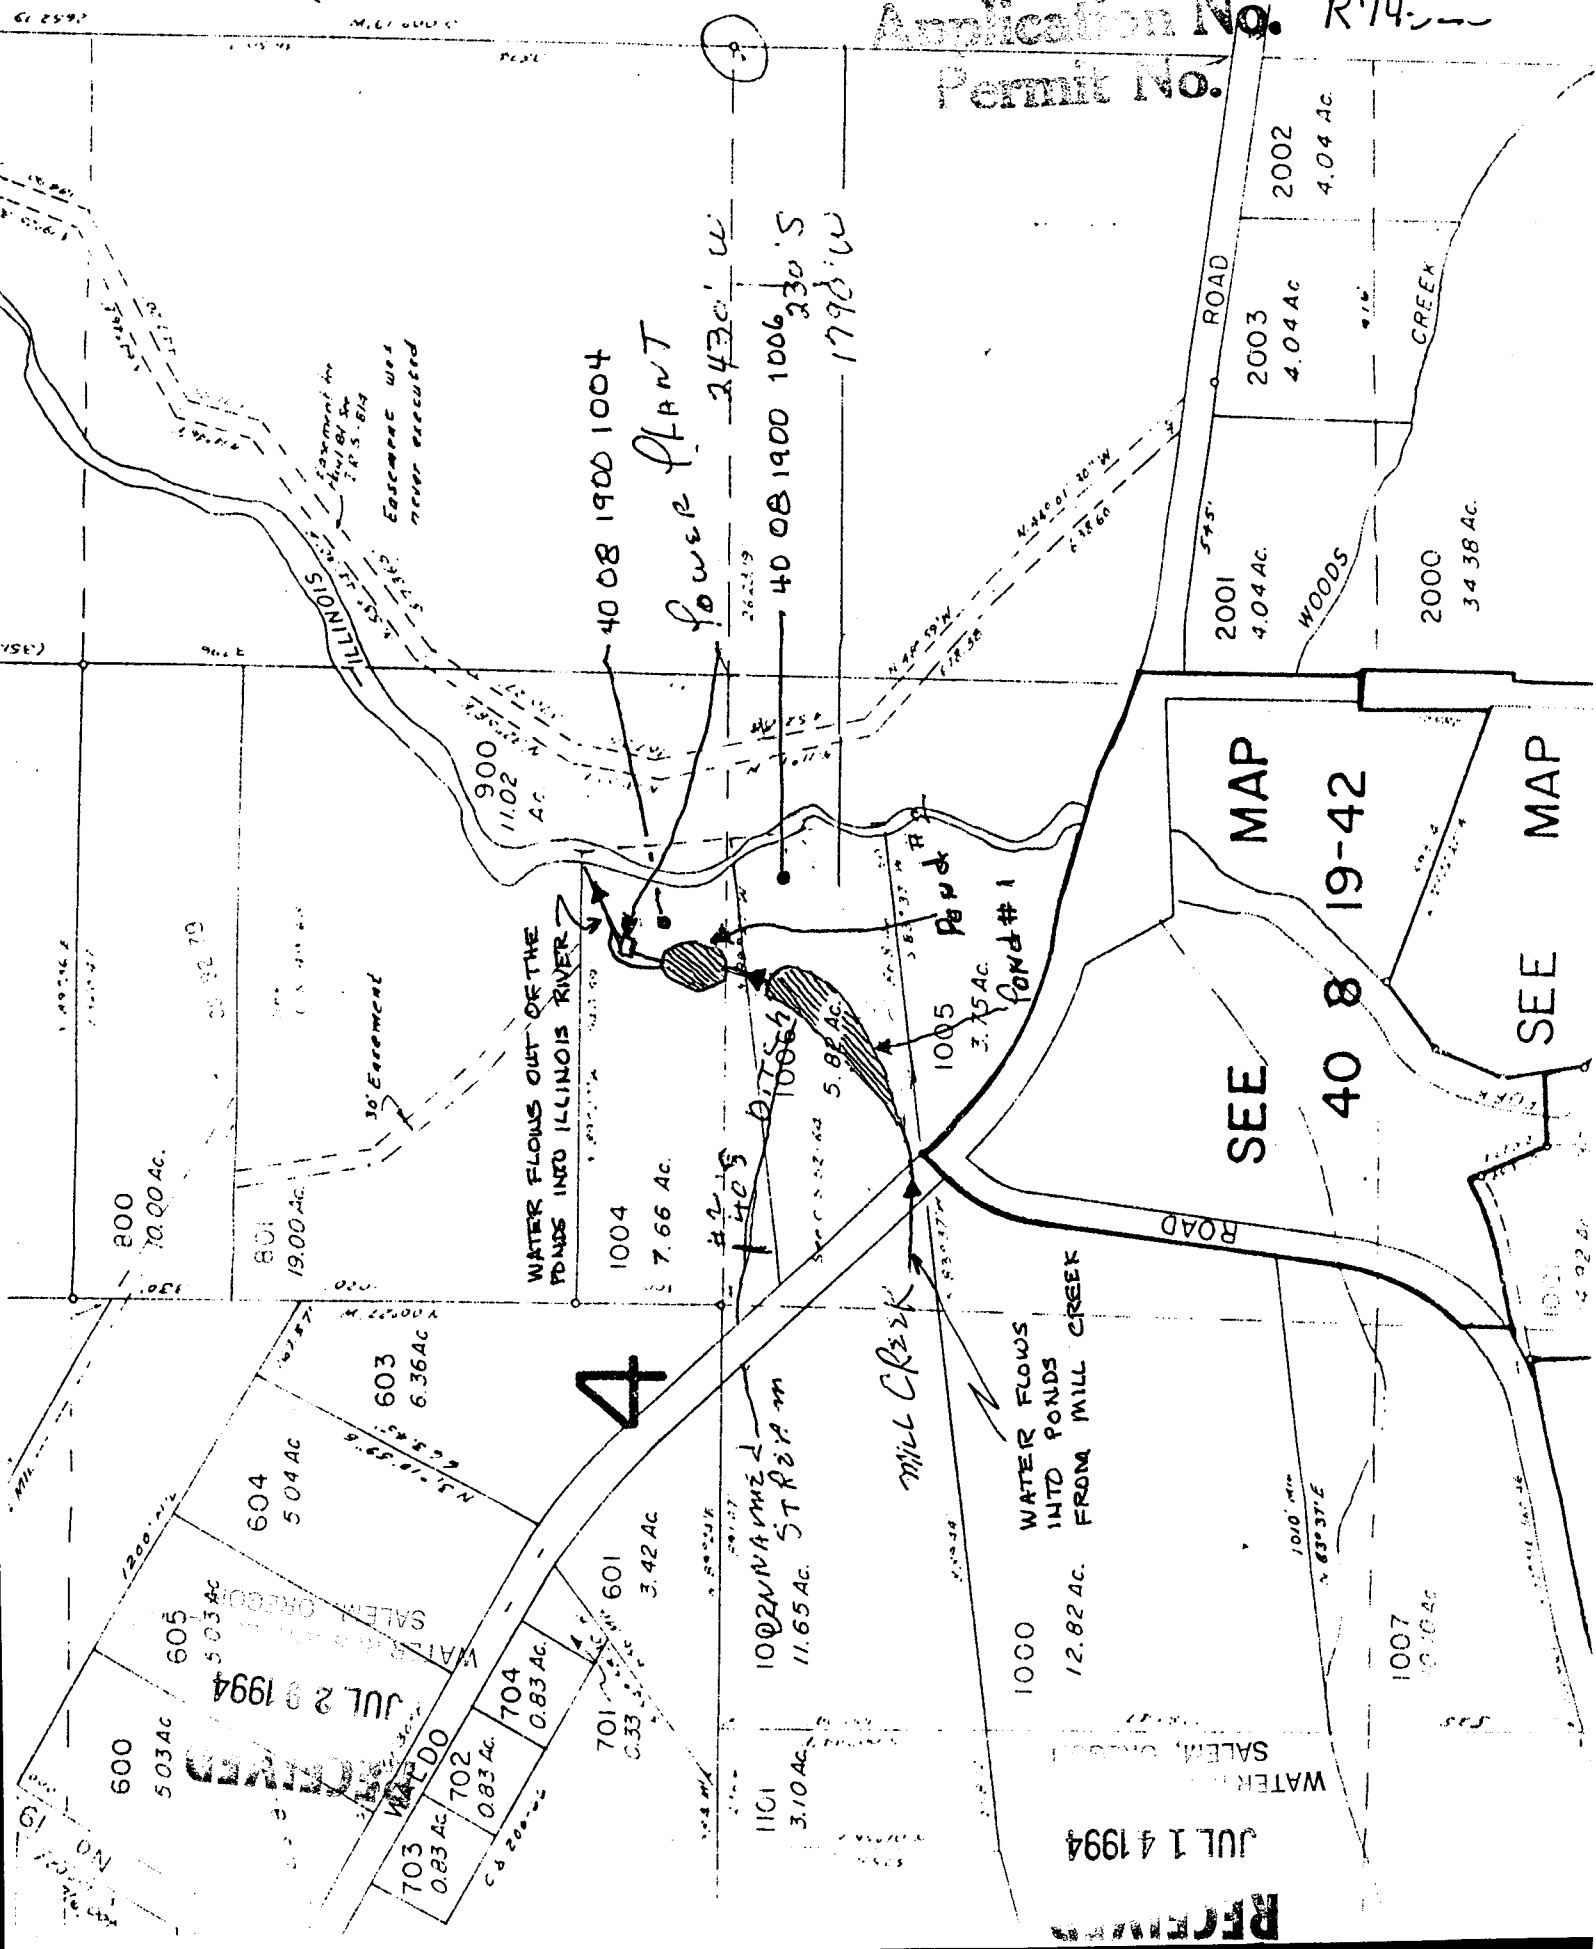

SEE MAP

40 8 19-42

SEE MAP

RETURNED

JUL 1 4 1994

WATER SALEM OREGON

JUL 2 8 1994

WATER SALEM OREGON