


not ph tar:
500.00 water
1000.00 sewer

WATER 5

SEE MAP 33 15

Application No. ²⁻7439
Permit No.

69194

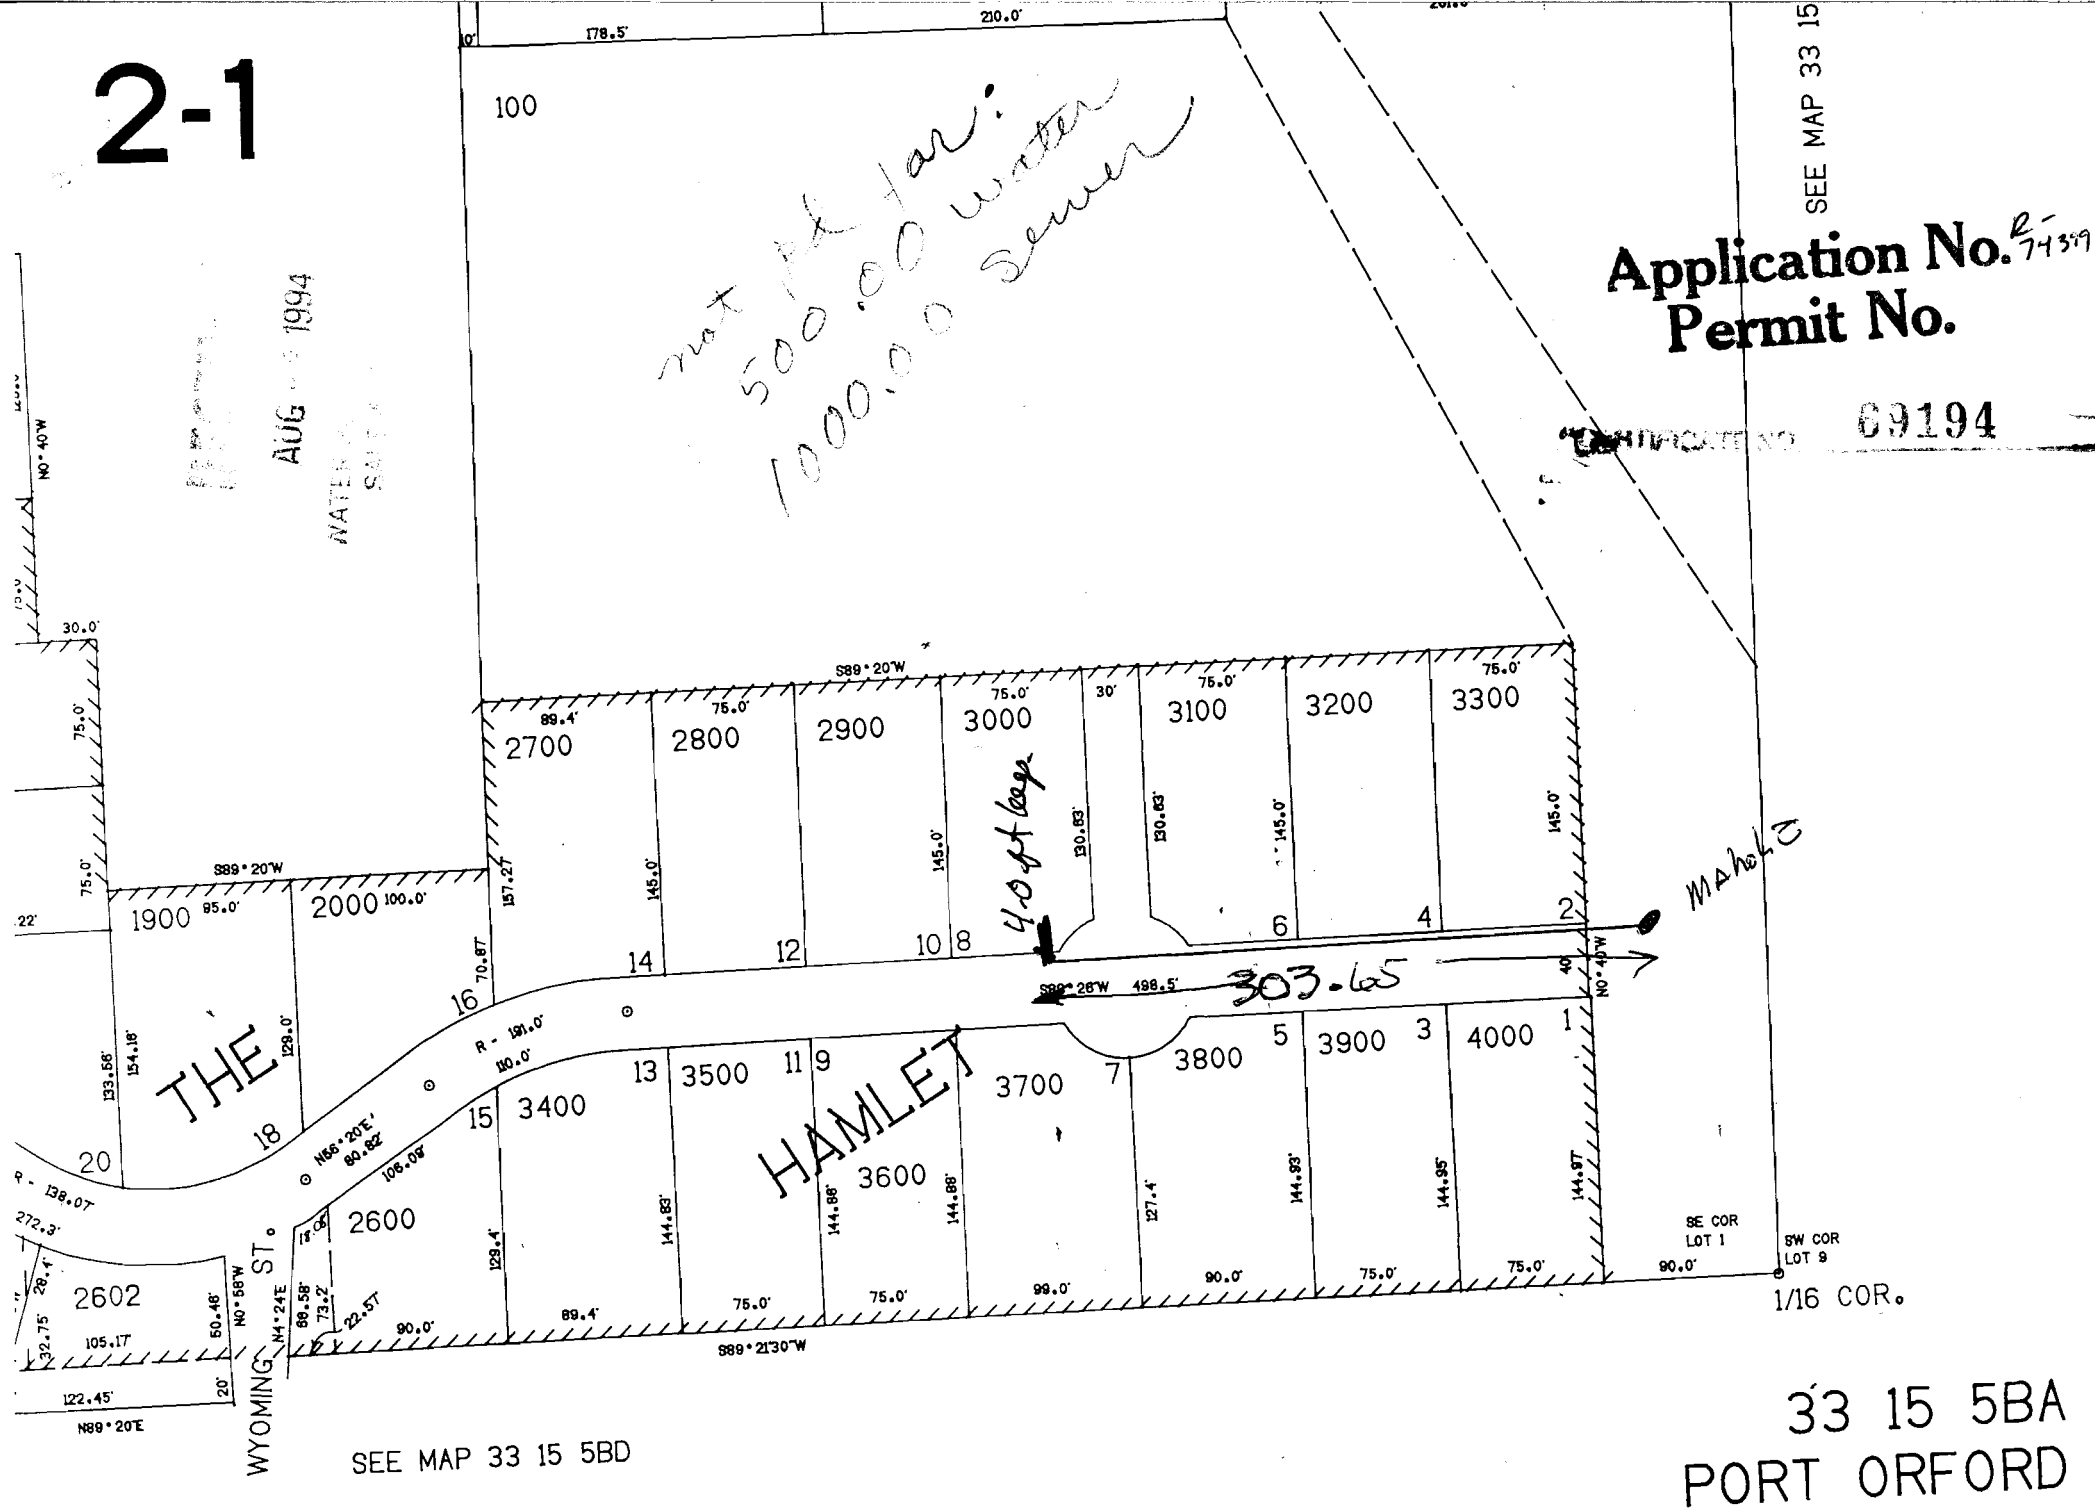

Application No. R-74399

Permit No.

WATER RIGHT APPLICATION MAP

T. 30/31 S., R. 15 W., W. M.

CERTIFICATE NO. 69194

APPLICANT:

CITY OF PORT ORFORD
P.O. BOX 310
PORT ORFORD, OR
97465

SURVEYED BY:

HGE, INC.
375 PARK AVE.
COOS BAY, OR 97420

MAPPING DATE:

JANUARY 25, 1994

NOTE:

THIS MAP IS FOR THE
PURPOSE OF IDENTIFYING
THE LOCATION OF THE
WATER RIGHT ONLY.

LEGEND

- CITY LIMITS
- EXISTING WATER LINE
- RAW WATER LINE
- PUMP STATION
- ▲ BOOSTER PUMP FOR SMALL RESIDENTIAL AREA

Ocean

Pacific

POINT OF
DIVERSION
HUBBARD CREEK
IMPOUNDMENT

N

1"=1000'

Kloquch
Rock

Certified Water Right Examiner
#041

Russ S. Dodge

Russ S. Dodge
Nov. 19, 1987

STATE OF OREGON

PORT ORFORD
.07 MG
RES.

HEADS STATE WAYSIDE

Nellies
Point

Graveyard
Point



ENGINEERS & PLANNERS

375 PARK AVE / COOS BAY, OR 97420

19 N W FIFTH ST / PORTLAND, OR 97209

No Final Proof Map available

No Permit Map available