


APR - 8 1994



The sketch below is made solely for the purpose of assisting in locating said premises and the Company assumes no liability for variations, if any, in dimensions and location ascertained by actual survey.

Subdivision

Map # R34E26

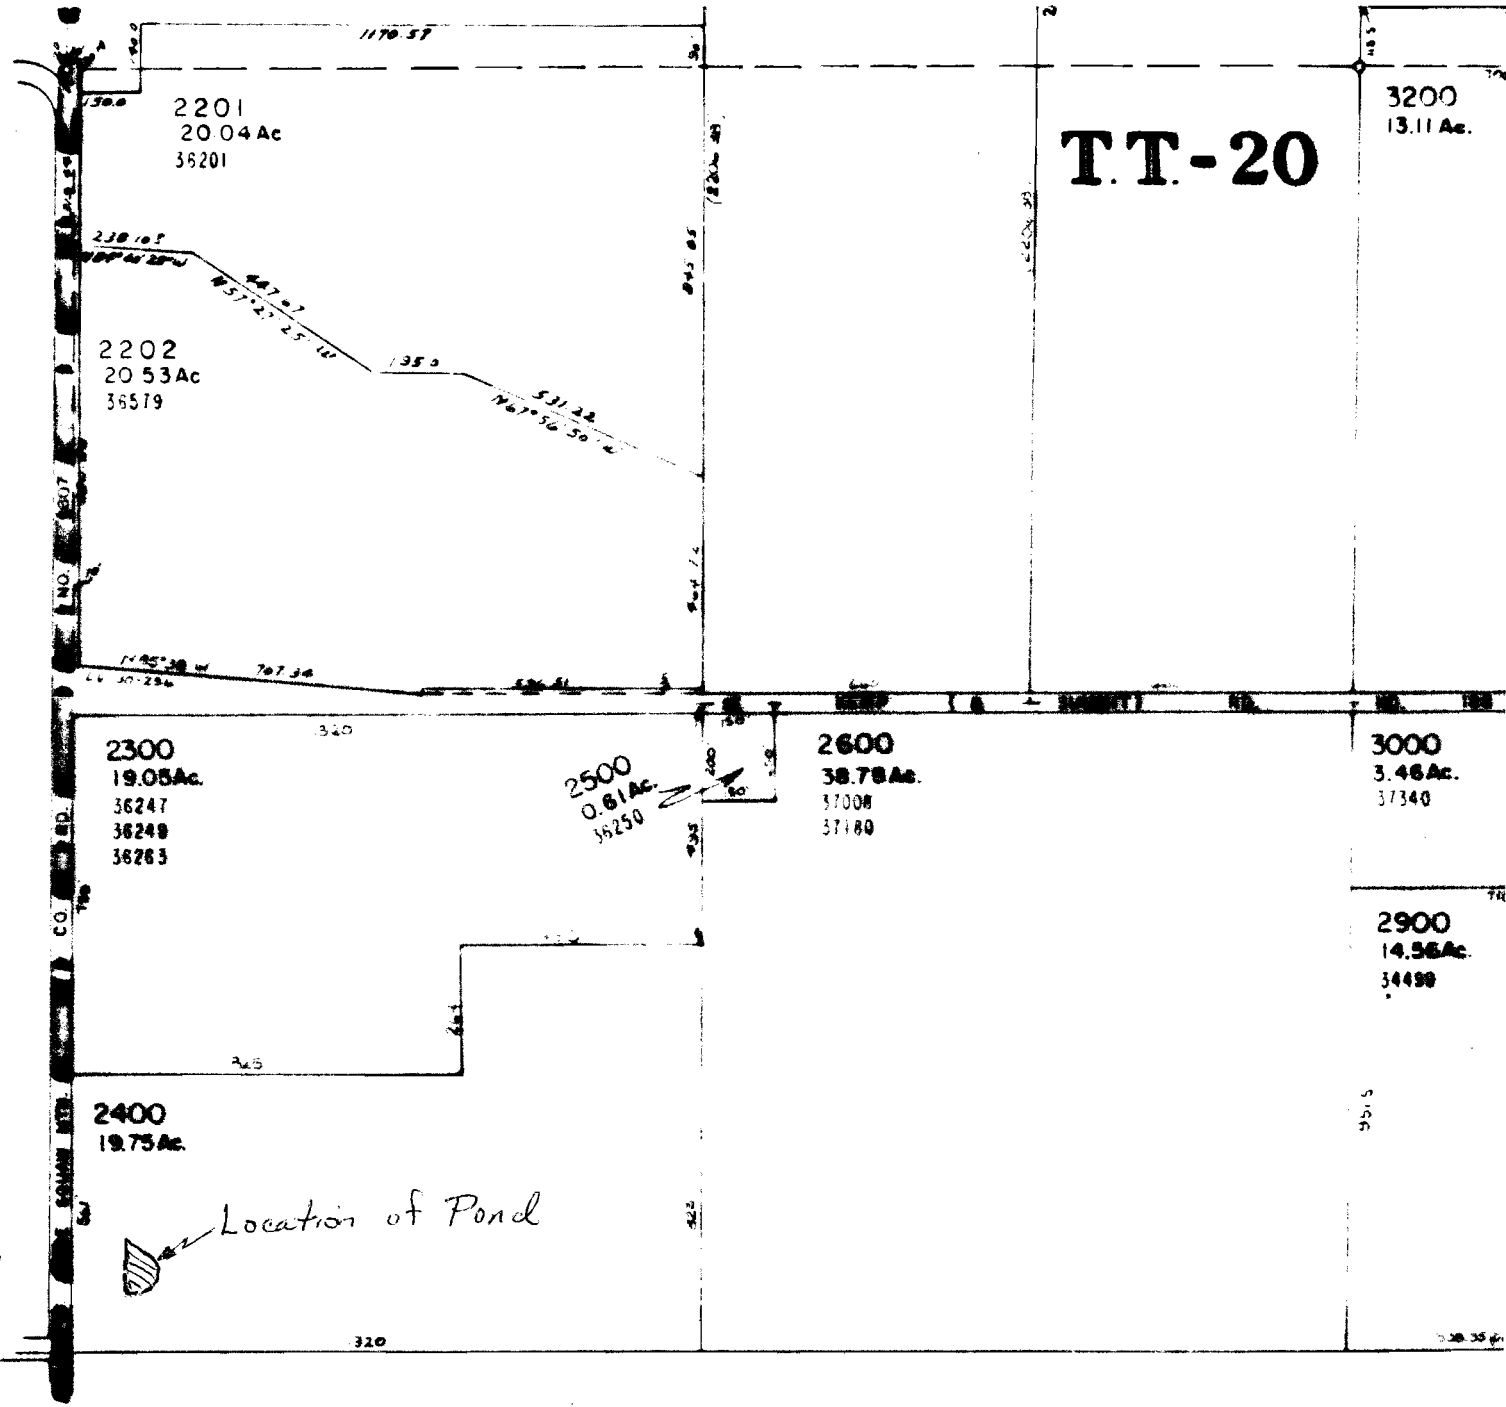

Location of Pond

Application No. R-74460
Permit No.
CERTIFICATE NO. 00005

SEE MAP 3 4E

34 35

No Final Proof Map available

No Permit Map available