


RECEIVED

AUG 29 1994

T.2N. R.4W. W.M.

WATER RES. DIV.
SALEM, OREGON

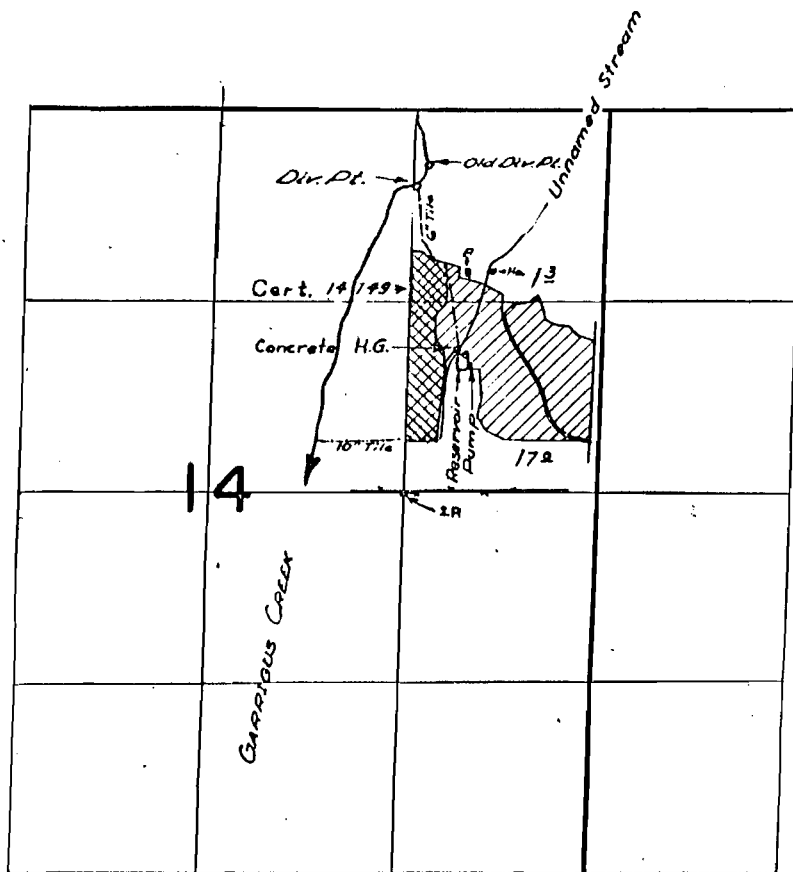

CERT. No. 14149

6.8 AC

18.3 AC

FINAL PROOF SURVEY
UNDER

R-34083 R-2369
Application No. 34084 Permit No. 26854
IN NAME OF

WM. P. HERB

Surveyed APRIL 28, 1964, by M. BISH