

SEC. 2 T.23S. R.5W. W.M.
DOUGLAS COUNTY

REVISED ON
10-31-91

23 5 2

CERTIFICATE NO. 69210

THIS MAP WAS PREPARED FOR
ASSESSMENT PURPOSE ONLY.

1"=400'

SEE MAP 22 5 35

Application No. R-74460
Permit No.

CANCELLED NO.S
401

34

32-00

35

36

SOUTH

SEE M46-35

SEE MAP 23 5 1

SEE MAP 23 5 3

RECEIVED

SEP - 1 1994

WATER RESOURCES DEPT.
SALEM, OREGON

RECEIVED

AUG 24 1994

WATER RESOURCES DEPT.
SALEM, OREGON


SEE HWY. DRWGS.
7B-14-15 & 8B-26-16

714,000

23 5 2

SEE MAP 23 5 11

1268,000

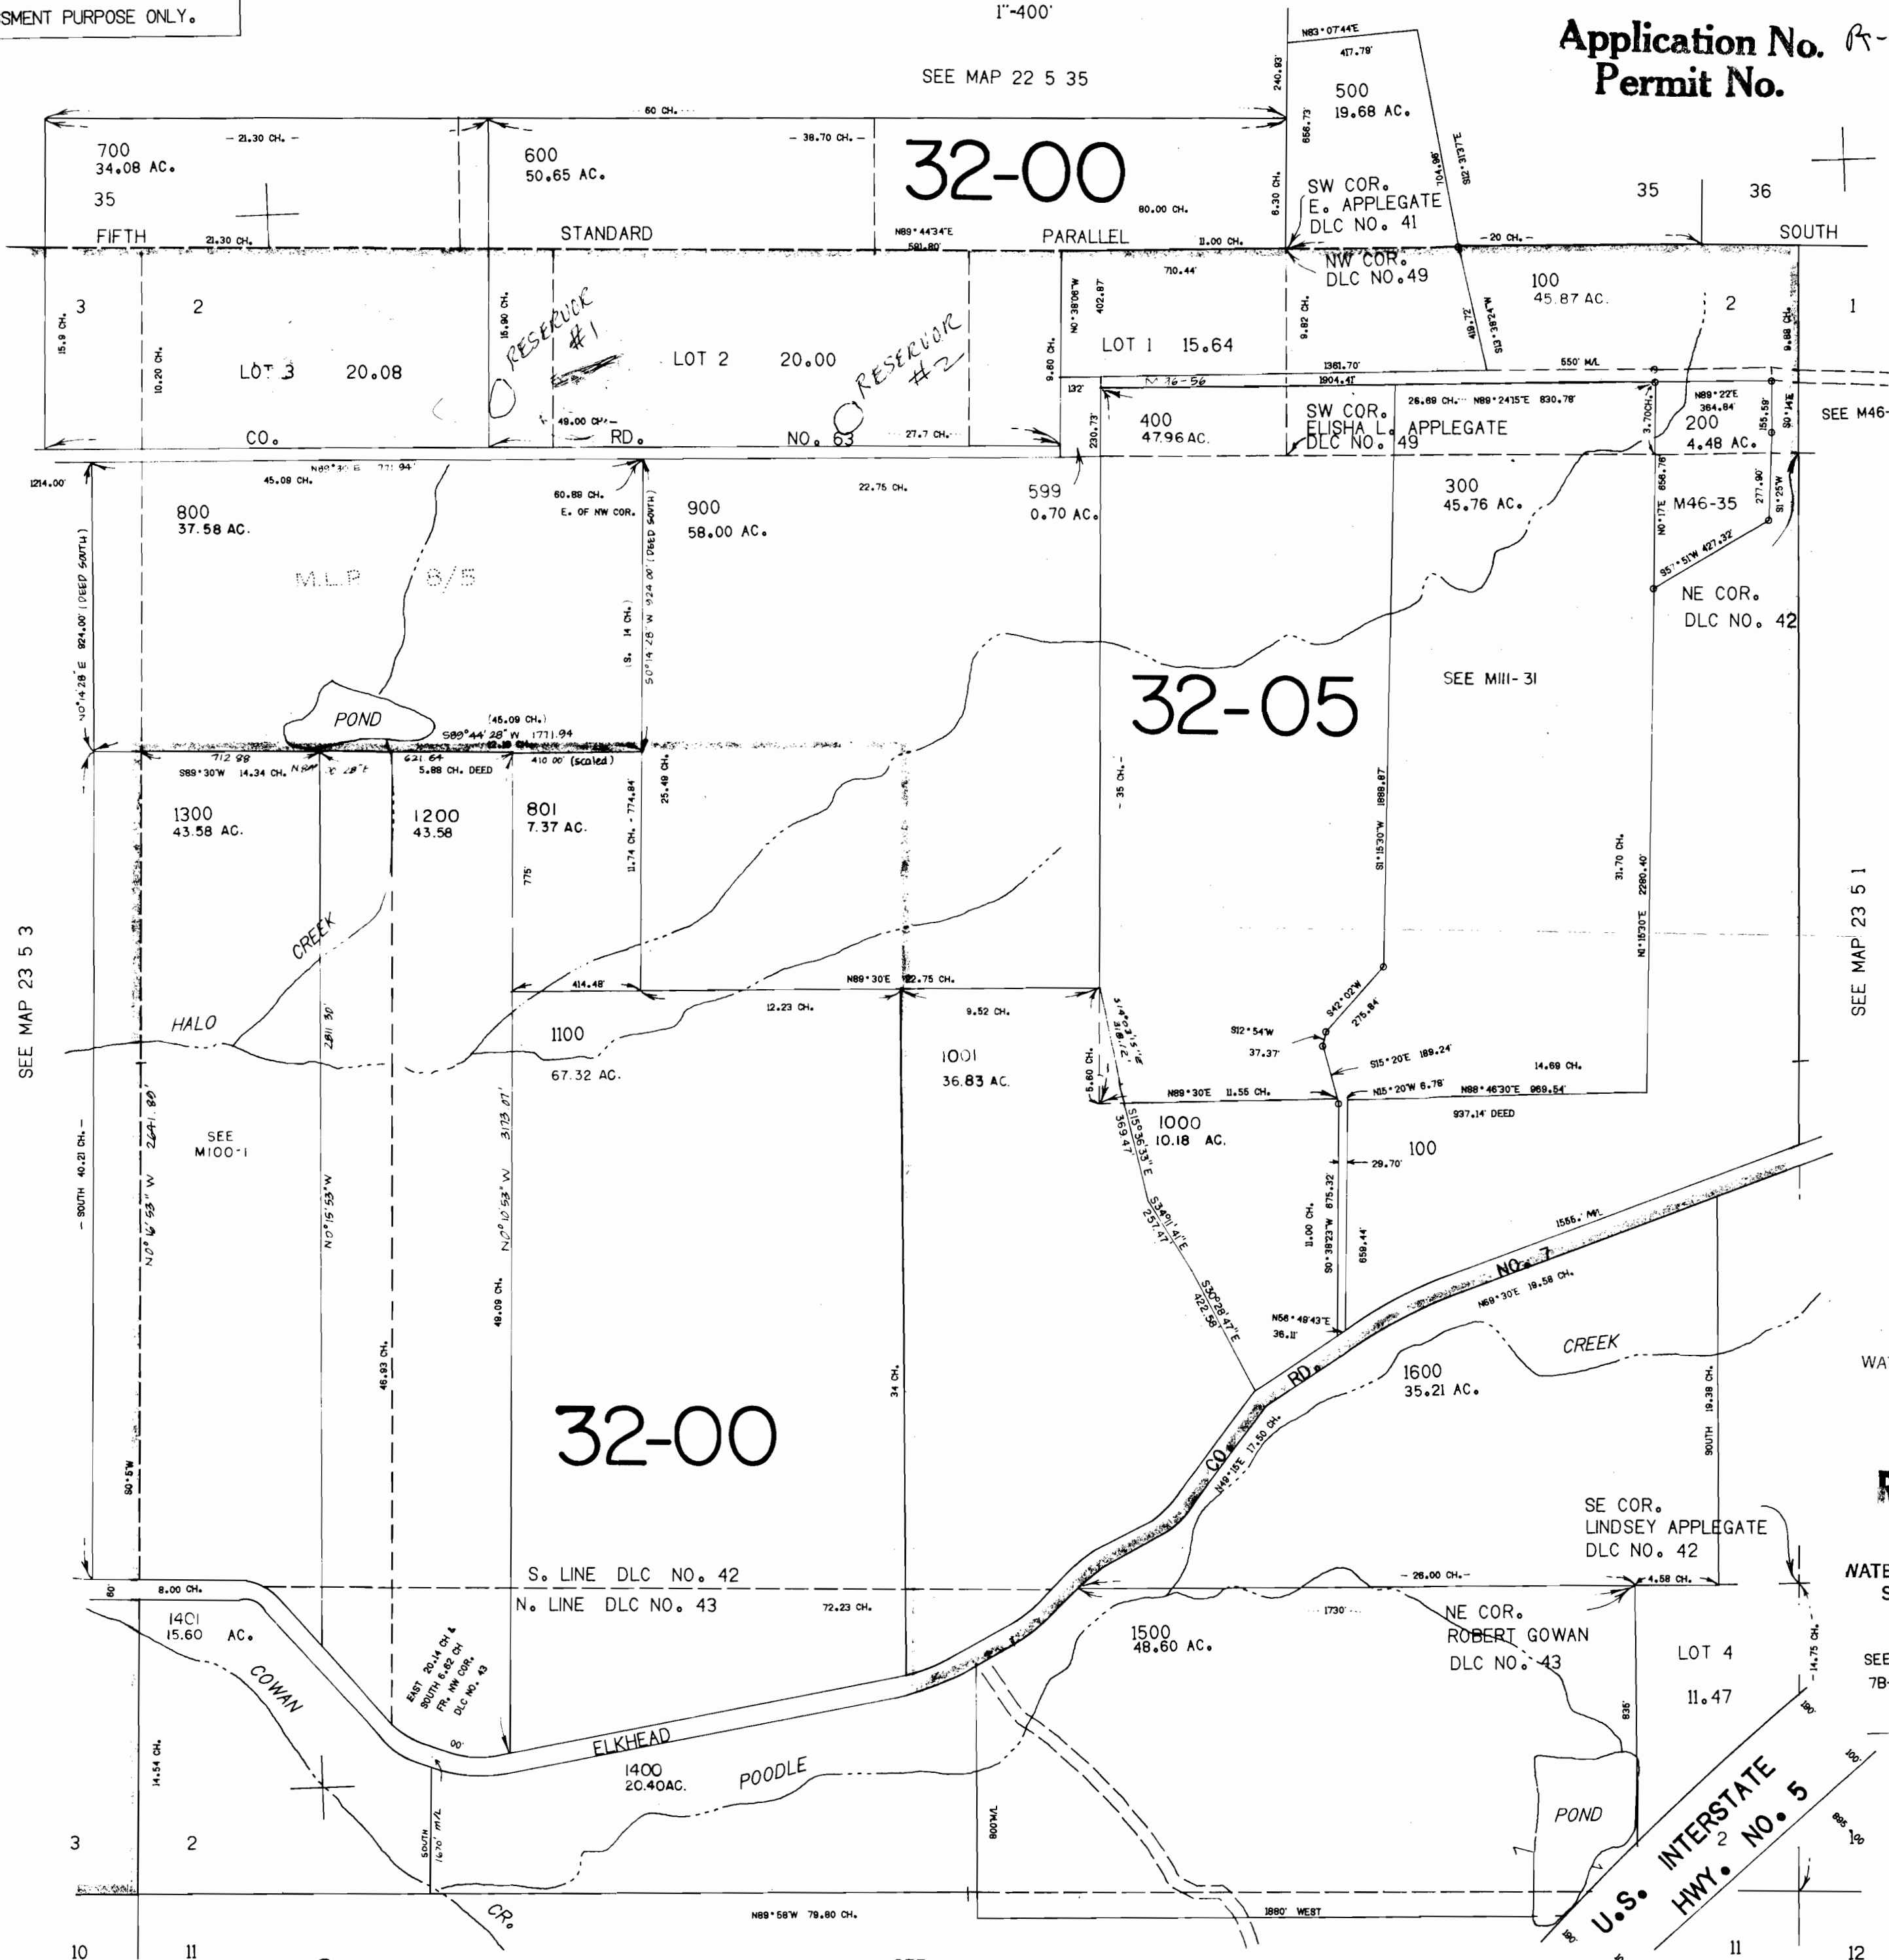

No Final Proof Map available

No Permit Map available