

RECEIVED

SEP - 1 1994


WATER RESOURCES DIVISION
SALEM, OREGON

T 2 N. R. 3 W. W. M.

"CERTIFICATE NO. 07211"

Application No. R-74461

Permit No.

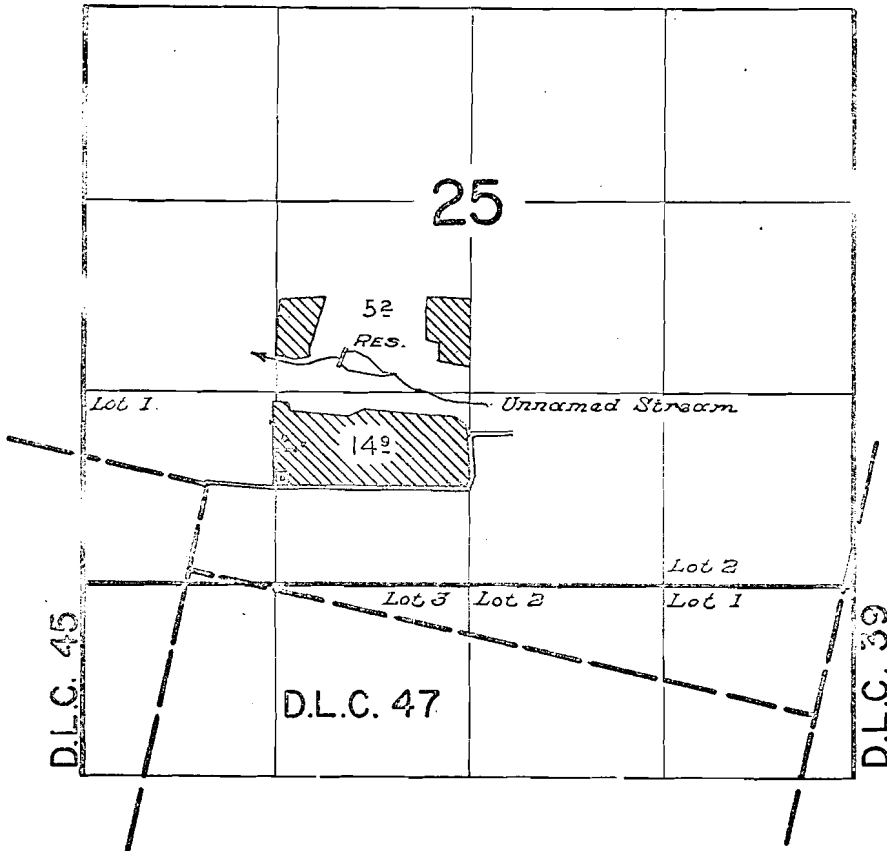

FINAL PROOF SURVEY
UNDER

Application No. ^{R-31222} 31223... Permit No. ^{R-1971} 24609...
IN NAME OF

BIGE & BERTHENA TANKERSLEY

Surveyed August 5 1960, by D. Jackson